

DEC 4 2 24 PM '96

Wanda R. Conway

REGISTER OF DEEDS

LAND CORNER RECORDATION CERTIFICATE
Filing Requirement of Act 74, Mich. P.A. 1970

For corners in

_____	Located In:	Corner Code #
(County)		
1. Public Land Survey	T 30N R 9W	J-1
	T _____ R _____	_____
	T _____ R _____	_____
	T _____ R _____	_____
2. Property Controlling in Section	S _____ T _____ R _____	_____
	S _____ T _____ R _____	_____
3. Miscellaneous Property in Sec.	S _____ T _____ R _____	_____
	S _____ T _____ R _____	_____
4. Lot No. _____, Recorded Plat _____		
5. Private Claims _____		

Register of Deeds Stamp & File Number

I, Terry B. Smith, in a field survey on Nov. 18, 1996 do hereby state that under requirements of P.A. 74, Michigan P.A. of 1970, the corner points mentioned in lines 1 and 2 above were in conformance with regulations and rules therefore as required in the current manual of survey instructions of the United States Department of the Interior, Bureau of Land Management or by a decree of a Court of Law and for that the corner points mentioned in lines 3, 4 and 5 above were in conformance with the rules of the Michigan Board of Land Surveyors or by a Decree of a Court of Law; established, re-established, monumented, recovered, found as expressed below:

NOTE: Not more than 2 corners, all in the same town and range, may be recorded on this certificate.

	A	B	C	D	E	F	G	H	I	J	K	L	M
1													
2		6		5		4		3		2		1	
3													
4		7		8		9		10		11		12	
5													
6		18		17		16		15		14		13	
7													
8		19		20		21		22		23		24	
9													
10		30		29		28		27		26		25	
11													
12		31		32		33		34		35		36	
13													

A. Description of original monument and accessories and/or subsequent restoration:


GL0 Ran North Township line
May 25, 1839 no mention of N 1/4 corner of Section 2

B. Description of corner evidence found and/or method applied in restoring or reestablishing corner:

found RR spike at fence corner

C. Description of monument for corner and accessories established to perpetuate locating the position of the corner:

Set Antrim County Monument
12" Bi-Maple S22E 69.00
16" Poplar S60E 58.75
12" Poplar S40W 12.35
5" R. Pine N40W 9.70

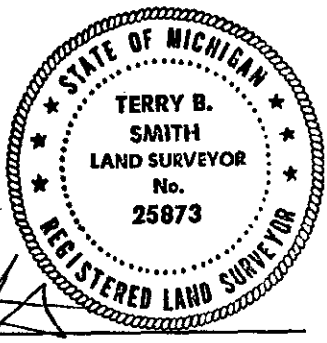

Ratified by Peer Group
in accordance with
PO 345.
Antrim County Chairman
Arthur L. Lennox
Arthur L. Lennox
Nov. 26, 1996

Signed by Terry B. Smith
Surveyor's Michigan License No. 25873

Date Dec. 3, 1996

95

002 331