

Dec 4 2 24 PM '96

Wanda R. Quidley

REGISTER OF DEEDS

LAND CORNER RECORDATION CERTIFICATE
Filing Requirement of Act 74, Mich. P.A. 1970

For corners in

_____	Located In:	Corner Code #
(County)		
1. Public Land Survey	T 30N R 9W	J-3
	T _____ R _____	_____
	T _____ R _____	_____
	T _____ R _____	_____
2. Property Controlling in Section	S _____ T _____ R _____	_____
	S _____ T _____ R _____	_____
3. Miscellaneous Property in Sec.	S _____ T _____ R _____	_____
	S _____ T _____ R _____	_____

Register of Deeds Stamp & File Number

4. Lot No. _____, Recorded Plat _____
5. Private Claims _____

I, Terry B. Smith, in a field survey on Nov. 18, 1996 do hereby state that under requirements of P.A. 74, Michigan P.A. of 1970, the corner points mentioned in lines 1 and 2 above were in conformance with regulations and rules therefore as required in the current manual of survey instructions of the United States Department of the Interior, Bureau of Land Management or by a decree of a Court of Law and /or that the corner points mentioned in lines 3, 4 and 5 above were in conformance with the rules of the Michigan Board of Land Surveyors or by a Decree of a Court of Law; established, re-established, monumented, recovered, found as expressed below:

NOTE: Not more than 2 corners, all in the same town and range, may be recorded on this certificate.

	A	B	C	D	E	F	G	H	I	J	K	L	M
1													
2		6		5		4		3		2		1	
3										●			
4		7		8		9		10		11		12	
5													
6		18		17		16		15		14		13	
7													
8		19		20		21		22		23		24	
9													
10		30		29		28		27		26		25	
11													
12		31		32		33		34		35		36	
13													

A. Description of original monument and accessories and/or subsequent restoration:


GLO Ran East between Sections 2 & 11
Random line -- no mention of correction
did not establish 1/4 section corner

B. Description of corner evidence found and/or method applied in restoring or reestablishing corner:

found 1/2" iron in east bound lane of
bituminous roadway

C. Description of monument for corner and accessories established to perpetuate locating the position of the corner:

Set Antrim County Monument
1/2" iron South 33.00
6" Poplar N40E 48.80
8" Cedar N60W 72.20
U.P. S60W 74.95

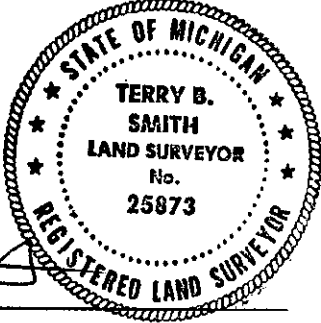

Ratified by Peer Group
in accordance with
PO 345.
Antrim County Chairman
Arthur L. Lennox
Arthur L. Lennox
Nov. 26, 1996

Signed by *Terry B. Smith*
Surveyor's Michigan License No. 25873

Date Dec. 3, 1996

002 330