

DEC 4 2 24 PM '96

LAND CORNER RECORDATION CERTIFICATE
Filing Requirement of Act 74, Mich. P.A. 1970

REGISTER OF DEEDS

For corners in

(County)	Located In:	Corner Code #
1. Public Land Survey	T <u>30N</u> R <u>9W</u>	<u>K-2</u>
	T <u> </u> R <u> </u>	<u> </u>
	T <u> </u> R <u> </u>	<u> </u>
	T <u> </u> R <u> </u>	<u> </u>
2. Property Controlling in Section	S <u> </u> T <u> </u> R <u> </u>	<u> </u>
	S <u> </u> T <u> </u> R <u> </u>	<u> </u>
3. Miscellaneous Property in Sec.	S <u> </u> T <u> </u> R <u> </u>	<u> </u>
	S <u> </u> T <u> </u> R <u> </u>	<u> </u>

Register of Deeds Stamp & File Number

4. Lot No. _____, Recorded Plat _____
5. Private Claims _____

I, Terry B. Smith in a field survey on Nov. 18, 1996 do hereby state that under requirements of P.A. 74, Michigan P.A. of 1970, the corner points mentioned in lines 1 and 2 above were in conformance with regulations and rules therefore as required in the current manual of survey instructions of the United States Department of the Interior, Bureau of Land Management or by a decree of a Court of Law and /or that the corner points mentioned in lines 3, 4 and 5 above were in conformance with the rules of the Michigan Board of Land Surveyors or by a Decree of a Court of Law; established, re-established, monumented, recovered, found as expressed below:

NOTE: Not more than 2 corners, all in the same town and range, may be recorded on this certificate.

	A	B	C	D	E	F	G	H	I	J	K	L	M
1													
2		6		5		4		3		2	●	1	
3													
4		7		8		9		10		11		12	
5													
6		18		17		16		15		14		13	
7													
8		19		20		21		22		23		24	
9													
10		30		29		28		27		26		25	
11													
12		31		32		33		34		35		36	
13													

A. Description of original monument and accessories and/or subsequent restoration:

GL0 Ran North between Sections 1 & 2

Sugar 10 N33E 47
Beech 9 S87W 3

B. Description of corner evidence found and/or method applied in restoring or reestablishing corner:

found PK Nail in northbound lane U.S. 31 Hwy.
found 1/2" iron under pvmt.
J. Fletcher survey recorded Liber 224 page 826
R. Dunn survey recorded Liber 213 page 127
B. Jones survey recorded L. 279 page 1281
LCRC 1-19-88 Liber 002 page 56


C. Description of monument for corner and accessories established to perpetuate locating the position of the corner:

Set Antrim County Monument
40" Maple S22E 72.75
35" Beech S45E 58.38
4th Guard Rail Post N50E 17.00
1/2" iron #20357 & 25873 N86W 75.00

Ratified by Peer Group
in accordance with
PO 345.
Antrim County Chairman

Arthur L. Lennox
Nov. 26, 1996

Signed by Terry B. Smith
Surveyor's Michigan License No. 25873

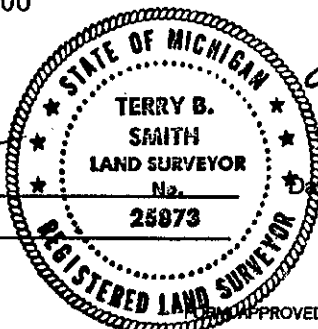

Date Dec. 3, 1996

002 328

92