

DEC 4 2 24 PM '96

LAND CORNER RECORDATION CERTIFICATE
Filing Requirement of Act 74, Mich. P.A. 1970

REGISTER OF DEEDS

For corners in

_____	Located In:	Corner Code #
(County)		
1. Public Land Survey	T <u>30NR</u> <u>9W</u>	<u>K-3</u>
	T _____	_____
	T _____	_____
	T _____	_____
2. Property Controlling in Section	S _____	_____
	S _____	_____
3. Miscellaneous Property in Sec.	S _____	_____
	S _____	_____

Register of Deeds Stamp & File Number

4. Lot No. _____, Recorded Plat _____
5. Private Claims _____

I, Terry B. Smith in a field survey on Nov. 18, 19 96 do hereby state that under requirements of P.A. 74, Michigan P.A. of 1970, the corner points mentioned in lines 1 and 2 above were in conformance with regulations and rules therefore as required in the current manual of survey instructions of the United States Department of the Interior, Bureau of Land Management or by a decree of a Court of Law and/or that the corner points mentioned in lines 3, 4 and 5 above were in conformance with the rules of the Michigan Board of Land Surveyors or by a Decree of a Court of Law; established, re-established, monumented, recovered, found as expressed below:

NOTE: Not more than 2 corners, all in the same town and range, may be recorded on this certificate.

	A	B	C	D	E	F	G	H	I	J	K	L	M
1													
2	6		5		4		3		2		1		
3													
4	7		8		9		10		11		12		
5													
6	10		17		16		15		14		13		
7													
8	19		20		21		22		23		24		
9													
10	30		29		28		27		26		25		
11													
12	31		32		33		34		35		36		
13													

A. Description of original monument and accessories and/or subsequent restoration:

GLO Ran S87°25'W between Sections 1 & 12
set post at 40.04 ch (midway)

Beech 10 N14W 42
Beech 9 S17E 35

B. Description of corner evidence found and/or method applied in restoring or reestablishing corner:

Dec. 5, 1911 F. Church found stake & Stump
4-25-78 survey B. Lennox & Assoc. found 1 1/2" iron
1983 B. Jones Survey Liber 279 page 1282
1983 B. Jones survey recorded Liber 279 page 1281
1988 LCRC recorded L. 002 page 56
Misc. notes: 1885 F. Church set stake


C. Description of monument for corner and accessories established to perpetuate locating the position of the corner:

Set Antrim County Monument
center line U.S. 31 Highway 5.00 feet east
40" Catalpa N85E 92.42
40" Maple N53E 88.35
U.P. S62W 85.80

Ratified by Peer Group
in accordance with
PO 345.
Antrim County Chairman

Arthur L. Lennox
Arthur L. Lennox
Nov. 26, 1996

Signed by *Terry B. Smith*
Surveyor's Michigan License No. 25873

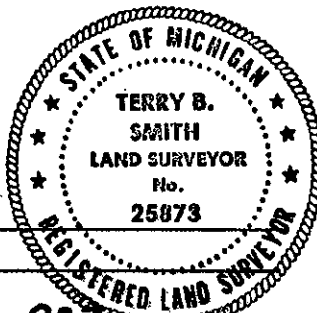

Date Dec. 3, 1996

002 327