

ANTRIM COUNTY  
MICHIGAN  
RECEIVED FOR RECORD

DEC 4 2 24 PM '96

LAND CORNER RECORDATION CERTIFICATE  
Filing Requirement of Act 74, Mich. P.A. 1970

*Wanda C. Orway*  
REGISTER OF DEEDS

For corners in

(County)	Located In:	Corner Code #
1. Public Land Survey	T 30NR 9W	K-4
	T R	
	T R	
	T R	
2. Property Controlling in Section	S T R	
	S T R	
3. Miscellaneous Property in Sec.	S T R	
	S T R	

Register of Deeds Stamp & File Number

4. Lot No. \_\_\_\_\_, Recorded Plat \_\_\_\_\_  
5. Private Claims \_\_\_\_\_

I, Terry B. Smith in a field survey on Nov. 18, 1996 do hereby state that under requirements of P.A. 74, Michigan P.A. of 1970, the corner points mentioned in lines 1 and 2 above were in conformance with regulations and rules therefore as required in the current manual of survey instructions of the United States Department of the Interior, Bureau of Land Management or by a decree of a Court of Law and/or that the corner points mentioned in lines 3, 4 and 5 above were in conformance with the rules of the Michigan Board of Land Surveyors or by a Decree of a Court of Law; established, re-established, monumented, recovered, found as expressed below:

	A	B	C	D	E	F	G	H	I	J	K	L	M
1													
2	6		5		4		3		2		1		
3													
4	7		8		9		10		11		12		
5													
6	18		17		16		15		14		13		
7													
8	19		20		21		22		23		24		
9													
10	30		29		28		27		26		25		
11													
12	31		32		33		34		35		36		
13													

NOTE: Not more than 2 corners, all in the same town and range, may be recorded on this certificate.

A. Description of original monument and accessories and/or subsequent restoration:

GLO Ran North between Sections 11 & 12  
set post at 40.00 ch (midway)

Beech 30 N84W 30  
Sug 10 S89E 45

B. Description of corner evidence found and/or method applied in restoring or reestablishing corner:

Dec. 5, 1911 F. Church used corner  
4-25-78 survey by Lennox & Assoc. found iron #21566  
1983 B. Jones Survey Liber 279 page 1282

1988 LCRC recorded L. 002 page 56


C. Description of monument for corner and accessories established to perpetuate locating the position of the corner:

Set Antrim County Monument  
1/2" iron West 74.90  
10" J. Pine N40W 108.35  
Pipe Line Marker N82W 62.08  
U.P. S40E 134.75

Ratified by Peer Group  
in accordance with  
PO 345.

*Arthur L. Lennox*  
Antrim County Chairman

Arthur L. Lennox  
Nov. 26, 1996

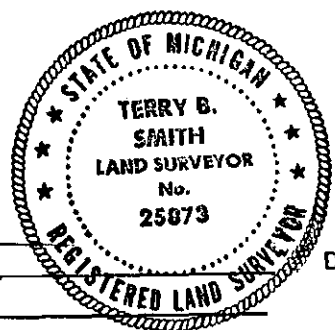

Signed by *Terry B. Smith*  
Surveyor's Michigan License No. 25873

Date Dec. 3, 1996

90

002 326