

ANTRIM COUL...
MICHIGAN
RECEIVED FOR RECORD
DEC 4 2 24 PM '96

LAND CORNER RECORDATION CERTIFICATE
Filing Requirement of Act 74, Mich. P.A. 1970 *and R. Boundary*

For corners in

(County)	Located In:	Corner Code #
1. Public Land Survey	T 30N R 9W	L-3
	T ___ R ___	_____
	T ___ R ___	_____
	T ___ R ___	_____
2. Property Controlling in Section	S ___ T ___ R ___	_____
	S ___ T ___ R ___	_____
3. Miscellaneous Property in Sec.	S ___ T ___ R ___	_____
	S ___ T ___ R ___	_____

REGISTER OF DEEDS

Register of Deeds Stamp & File Number

4. Lot No. _____, Recorded Plat _____
5. Private Claims _____

I, Terry B. Smith, in a field survey on Nov. 18, 19 96 do hereby state that under requirements of P.A. 74, Michigan P.A. of 1970, the corner points mentioned in lines 1 and 2 above were in conformance with regulations and rules therefore as required in the current manual of survey instructions of the United States Department of the Interior, Bureau of Land Management or by a decree of a Court of Law and/or that the corner points mentioned in lines 3, 4 and 5 above were in conformance with the rules of the Michigan Board of Land Surveyors or by a Decree of a Court of Law; established, re-established, monumented, recovered, found as expressed below:

NOTE: Not more than 2 corners, all in the same town and range, may be recorded on this certificate.

	A	B	C	D	E	F	G	H	I	J	K	L	M
1													
2	6			5		4		3		2		1	
3													
4	7			8		9		10		11		12	
5													
6	18			17		16		15		14		13	
7													
8	19			20		21		22		23		24	
9													
10	30			29		28		27		26		25	
11													
12	31			32		33		34		35		36	
13													

A. Description of original monument and accessories and/or subsequent restoration:

GLO Ran correction between Sec. 1 & 12
established 1/4 post at 40.04 ch.
Beech 10 N14W 42
Beech 9 S17E 35

B. Description of corner evidence found and/or method applied in restoring or reestablishing corner:

1885 County Surveyor F. Church survey for James Peckham
1885 Misc. Notes: F. Church found stumps of both witnesses & set new witnesses
Beech 4 S76 1/2 S 79 1/2
Beech 2 S48W 65 1/2
Hemlock 10 S43 1/2 W 89 1/2
1988 LCRC Liber 002 page 51


C. Description of monument for corner and accessories established to perpetuate locating the position of the corner:

Set Antrim County Monument
40" Maple N70W 219.75
SE Section corner East 2674.46
No other witnesses available
monument is in McLachlan Road with fields on all sides

Ratified by Peer Group
in accordance with
PQ 345.
Antrim County Chairman

Arthur L. Lennox
Arthur L. Lennox
Nov. 26, 1996

Signed by *Terry B. Smith* 25873
Surveyor's Michigan License No. _____

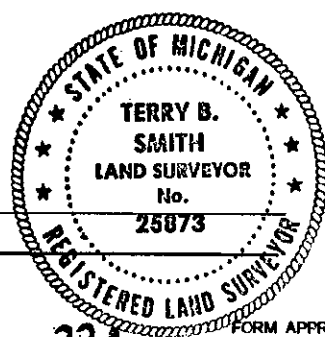

Date Dec. 3, 1996

002 324