

DEC 4 2 23 PM '96

LAND CORNER RECORDATION CERTIFICATE  
Filing Requirement of Act 74, Mich. P.A. 1970 *Wanda B. Conway*

REGISTER OF DEEDS

For corners in

(County)	Located In:	Corner Code #
1. Public Land Survey	T 30N R 9W	M-3
	T ___ R ___	_____
	T ___ R ___	_____
	T ___ R ___	_____
2. Property Controlling in Section	S ___ T ___ R ___	_____
	S ___ T ___ R ___	_____
3. Miscellaneous Property in Sec.	S ___ T ___ R ___	_____
	S ___ T ___ R ___	_____

Register of Deeds Stamp & File Number

4. Lot No. \_\_\_\_\_, Recorded Plat \_\_\_\_\_  
5. Private Claims \_\_\_\_\_

I, Terry B. Smith, in a field survey on Nov. 18, 19 96 do hereby state that under requirements of P.A. 74, Michigan P.A. of 1970, the corner points mentioned in lines 1 and 2 above were in conformance with regulations and rules therefore as required in the current manual of survey instructions of the United States Department of the Interior, Bureau of Land Management or by a decree of a Court of Law and/or that the corner points mentioned in lines 3, 4 and 5 above were in conformance with the rules of the Michigan Board of Land Surveyors or by a Decree of a Court of Law, established, re-established, monumented, recovered, found as expressed below:

NOTE: Not more than 2 corners, all in the same town and range, may be recorded on this certificate.

	A	B	C	D	E	F	G	H	I	J	K	L	M
1													
2		6		5		4		3		2		1	
3													
4		7		8		9		10		11		12	
5													
6		18		17		16		15		14		13	
7													
8		19		20		21		22		23		24	
9													
10		30		29		28		27		26		25	
11													
12		31		32		33		34		35		36	
13													

A. Description of original monument and accessories and/or subsequent restoration:


GLO Ran North on East side of Sec 12  
set Cedar post for sec. corner  
Hem 30 S21W 37  
Hem 20 N12W 22  
Beech 12 S24E 43  
Hem 20 N21E 23

B. Description of corner evidence found and/or method applied in restoring or reestablishing corner:

1885 County Surveyor F. Church survey for James Peckham  
1974 M. Feindt survey, L 215 page 67  
1975 survey by Lennox & Assoc  
1988 LCRC Liber 002 page 51  
1989 survey by Lennox & Assoc.  
1996 found 1/2" iron & witnesses

C. Description of monument for corner and accessories established to perpetuate locating the position of the corner:

Set Antrim County Monument  
10" Spruce S80E 45.00  
12" Pine N60E 66.15  
Bi-Birch N40W 91.76  
10" Poplar S55W 77.35

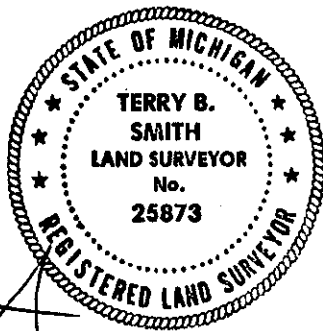

Ratified by Peer Group  
in accordance with  
PO 345.

Antrim County Chairman

*Arthur L. Lennox*

Arthur L. Lennox  
Nov. 26, 1996

Signed by Terry B. Smith  
Surveyor's Michigan License No. 25873

Date Dec 3, 1996

86

002 322