

LAND CORNER RECORDATION CERTIFICATE
Filing Requirement of Act 74, Mich. P.A. 1970

For corners in
ALPENA

(County)

Located In:

Corner Code ~~##~~

- | | | | | | |
|------------------------------------|---|-----|---|----|----------|
| 1. Public Land Survey | T | 31N | R | 5E | L-8, L-9 |
| | T | | R | | |
| | T | | R | | |
| | T | | R | | |
| 2. Property Controlling in Section | S | | T | R | |
| | S | | T | R | |
| 3. Miscellaneous Property in Sec. | S | | T | R | |
| | S | | T | R | |

Register of Deeds Stamp & File Number

4. Lot No. _____, Recorded Plat _____
 5. Private Claims _____

	A	B	C	D	E	F	G	H	I	J	K	L	M
2	6	5	4	3	2	1							
3													
4	7	8	9	10	11	12							
5													
6	18	17	16	15	14	13							
7													
8	19	20	21	22	23	24							
9													
10	30	29	28	27	26	25							
11													
12	31	32	33	34	35	36							
13													

I, CARL T. KIISKILA, in a field survey on NOVEMBER 30, 19 95, do hereby certify that under requirements of P.A. 74, Michigan P.A. of 1970, the corner points mentioned in lines 1 and 2 above were in conformance with regulations and rules therefore as required in the current manual of survey instructions of the United States Department of the Interior, Bureau of Land Management or by a decree of a Court of Law and/or that the corner points mentioned in lines 3, 4 and 5 above were in conformance with the rules of the Michigan Board of Land Surveyors or by a Decree of a Court of Law; established, re-established, monumented, re-monumented, recovered, found as expressed below:

NOTE: Not more than 4 corners, all in the same town and range, may be recorded on this certificate.

A. Description of original monument and accessories and/or subsequent restoration:


L-8	L-9
(NO EVIDENCE OF G.L.O. CORNER, B.T.'S, LINE TREES OR TOPOGRAPHY, AS CALLED OUT IN G.L.O. LINE NOTES; UNLESS NOTED IN ITEM "B" BELOW.)	

B. Description of corner evidence found and/or method applied in restoring or reestablishing corner:

L-8	L-9
FOUND 3/4" PIPE FOR CTR. OF SEC. 24. CORNER FITS PROPER SUB'D. OF SEC PER STANDARD BLM INSTRUCTIONS AND ALSO CERT. OF SUR BY D.GUTHRIE DATED 4-24-95 IN S-24. COR IS IN CTR OF E-W RD AND 14 1/2' EAST OF CTR. OF DRIVEWAY TO NORTH.	FD 1/2" IRON IN MON BOX FOR THE S1/4 COR OF SEC. 24. CORNER FITS 1976 CERT. OF SURVEY L.S.S., Pg. 382 BY D.MacNEILL. CORNER ALSO FITS 1892 SURVEY BY JOHN H. LEROY IN SEC. 24. CTR OF DRIVEWAY TO NORTH IS 18 1/2' WEST.

C. Description of monument for corner and accessories established to perpetuate locating the position of the corner:

L-8	L-9
FD 3/4" PIPE OVER 5/8" PEROD (8" BELOW RD GRADE). #FENCE POST S07°W 33.15' #16" APPLE N38°W 79.26' 11" BOX ELDER N68°W 60.22' STEEL GATE POST N02°W 49.66' TEL. RISER BOX N12°E 31.8'	FD 1/2" IRON ROD IN MON BOX. #24" MAPLE N24°E 49.24' UTILITY POLE N47°E 104.80' FENCE BRACE POST S10°E 58.61' RED TOP CEDAR POST (PK) S20°W 58.72' CTR. M-32 SOUTH 6'

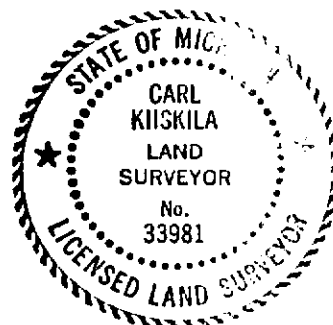

*= WIT. BY D.GUTHRIE, PS#22435 *= MSHD 1967 WIT.

Signed by Carl T. Kiiskila

Date 1-23-96

Surveyor's Michigan License No. 33981