

FEB 03 1998

1997 Alpena County Remonumentation

LAND CORNER RECORDATION CERTIFICATE
Filing Requirement of Act 74, Mich. P.A. 1970

SECTION 00002 Page 0095
Liber

For corners in

Alpena (County)	Located In:	Corner Code #
1. Public Land Survey	T 32N R 05E	F13
	T 31N R 05E	F01
	T R	
	T R	
2. Property Controlling in Section	S T R	
	S T R	
3. Miscellaneous Property in Sec.	S T R	
	S T R	

STATE OF MICHIGAN
County of Alpena
Recorded
08-25-1997 12:01:21
Kathy J. Matash
REGISTER OF DEEDS

Register of Deeds Stamp & File Number

4. Lot No. _____, Recorded Plat _____
5. Private Claims _____

I, Wayne T. Lewis, in a field survey on March 3, 1997 do hereby state that under requirements of P.A. 74, Michigan P.A. of 1970, the corner points mentioned in lines 1 and 2 above were in conformance with regulations and rules therefore as required in the current manual of survey instructions of the United States Department of the Interior, Bureau of Land Management or by a decree of a Court of Law and/or that the corner points mentioned in lines 3, 4 and 5 above were in conformance with the rules of the Michigan Board of Land Surveyors or by a Decree of a Court of Law; established, re-established, monumented, recovered, found as expressed below:

NOTE: Not more than 2 corners, all in the same town and range, may be recorded on this certificate.

A	B	C	D	E	F	G	H	I	J	K	L	M
1												
2	6		5		4		3		2		1	
3												
4	7		8		9		10		11		12	
5												
6	18		17		16		15		14		13	
7												
8	19		20		21		22		23		24	
9												
10	30		29		28		27		26		25	
11												
12	31		32		33		34		35		36	
13												

A. Description of original monument and accessories and/or subsequent restoration:

- 1855: Butler Ives, D.S. Set post. Witnesses given: Dead Maple 12 N 12° E 21, Dead Birch 12 S 5° E 17.
- 1913: J. McNeil & W. Leroy No monumentation given. Witnesses given: White Pine Stump 36 N 1°30' E 60.
- 1990: Thomas L. Fabis, P.S. Found 2" gas pipe. Corner recorded in Liber 1, page 222 by Thomas L. Fabis. Witnesses given: N 35° E 36.54' 5" White Pine (found DNR tag), N 32° W 40.67' 11" Jack Pine (found DNR tag), S 50° W 42.95' 5" Red Pine, S 44° E 57.90' 13" White Pine.
- 1995: Carl T. Kiiskila, P.S. Found 2" gas pipe. No witnesses given.


B. Description of corner evidence found and/or method applied in restoring or reestablishing corner:

1997: Found 1-1/2" pipe w/nail & tag #31591. Set 1/2" rerod inside of pipe.

P.A. 345 ALPENA COUNTY
PEER APPROVED 5/10/97
[Signature]

C. Description of monument for corner and accessories established to perpetuate locating the position of the corner:

1997: Placed appropriately stamped Alpena County Remonumentation 3" aluminum cap on set 1/2" rerod, 6" below road surface.

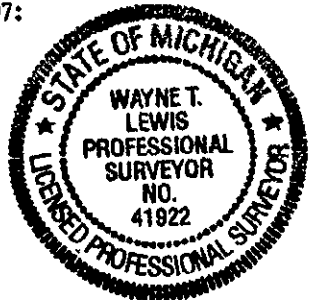

- Witnesses given:
- N 30° W 40.05' 12" Jack Pine (found blaze)
 - N 30° E 36.50' 10" White Pine (found blaze)
 - S 50° W 42.95' 8" Red Pine (found blaze)
 - S 40° E 57.90' 18" White Pine (found tag #31591)

Signed by Wayne T. Lewis
Surveyor's Michigan License No. 41922

Date August 21, 1997