

LAND CORNER RECORDATION CERTIFICATE
Filing Requirement of Act 74, Mich. P.A. 1970

For corners in

ALPENA

(County)

Located In:

Corner Code #:

- | | | | | | | | |
|------------------------------------|---|------------|---|-----------|-------|-------|--------------|
| 1. Public Land Survey | T | <u>31N</u> | R | <u>6E</u> | _____ | | |
| | T | _____ | R | _____ | _____ | | |
| | T | _____ | R | _____ | _____ | | |
| | T | _____ | R | _____ | _____ | | |
| 2. Property Controlling in Section | S | <u>10</u> | T | _____ | R | _____ | <u>2</u> |
| | S | <u>10</u> | T | _____ | R | _____ | <u>9</u> |
| 3. Miscellaneous Property in Sec. | S | <u>10</u> | T | _____ | R | _____ | <u>1-3,7</u> |
| | S | <u>10</u> | T | _____ | R | _____ | <u>1-3,2</u> |

Register of Deeds Stamp & File Number

4. Lot No. _____, Recorded Plat _____
 5. Private Claims _____

I, Carl R. Johnson, in a field survey on May 13, 19 92, do hereby certify that under requirements of P.A. 74, Michigan P.A. of 1970, the corner points mentioned in lines 1 and 2 above were in conformance with regulations and rules therefore as required in the current manual of survey instructions of the United States Department of the Interior, Bureau of Land Management or by a decree of a Court of Law and/or that the corner points mentioned in lines 3, 4 and 5 above were in conformance with the rules of the Michigan Board of Land Surveyors or by a Decree of a Court of Law; established, re-established, monumented, re-monumented, recovered, found as expressed below:


NOTE: Not more than 4 corners, all in the same town and range, may be recorded on this certificate.

A	B	C	D	E	F	G	H	I	J	K	L	M
2	6	5	4	3	2	1						
3												
4	7	8	9	10	11	12						
5												
6	18	17	16	15	14	13						
7												
8	19	20	21	22	23	24						
9												
10	30	29	28	27	26	25						
11												
12	31	32	33	34	35	36						
13												

- A. Description of original monument and accessories and/or subsequent restoration:

2	9	I-3,7
---	---	-------

I-3,2

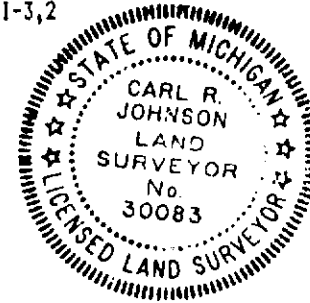

- B. Description of corner evidence found and/or method applied in restoring or reestablishing corner:

2	9	I-3,7	I-3,2
Set by standard survey procedure for subdivision of a section.	Set by standard survey procedure for subdivision of a section.	Set on line between sections 10/11 on right bank of Thunder Bay River. Original meander corner would fall 21 feet northerly of this point. Corner is S06-25-25E, 87.0 feet from the NE corner of section 10, which falls in river.	Set on north line of section 10, record distance from computed meander corner one chain south of the NE corner of section 10. Falls at a point N83-31-43W, 298.84 feet from proportional NE corner of section 10, which falls in Thunder Bay River.

- C. Description of monument for corner and accessories established to perpetuate locating the position of the corner:

2	9	I-3,7	I-3,2
E1/8 Cor. on N. side of sec. 10. Set 5/8" Bar w/cap 8" R.Pine N40W 17.0 ft 8" W.Pine N54E 38.5 ft 8" W.Pine S14E 24.0 ft 8" R.Pine S22W 21.0 ft	E1/8 Cor on E-W 1/4 line Set 5/8" Bar w/cap 6" Maple N11E 17.3 ft 10" Spruce Due East 37.5 ft 12" W. Pine S57W 1.6 ft 3/8" Bar S86W 10.4 ft	Witness Corner 10/11 Set DNR Mon. 10" Ash S22E 26.2 ft 10" Ash S50W 31.0 ft 6 feet north to right bank of river.	Meander Corner 3/10 Set DNR Mon. 4" Spruce S16E 5.2 ft 8" Spruce S77W 27.1 ft 60 feet east to right bank of river. 20 feet north to right bank of river.

Signed by Carl R. Johnson Date 7/7/92
 Surveyor's Michigan License No. 30083