LAND CORNER RECORDATION CERTIFICATE

Filing Requirement of Act 74, Mich. P.A. 1970

For corners in ALPENA (County)

	Located In:	Corner Code ##
1. Public Land Survey	T 31N R 6E	I-4
	T ___ R ___	
	T ___ R ___	
	T ___ R ___	
2. Property Controlling	S ___ T ___ R ___	
in Section	S ___ T ___ R ___	
3. Miscellaneous	S 10 T ___ R ___	I-4,7
Property in Sec.	S 10 T ___ R ___	I-3,7

Register of Deeds Stamp & File Number

4. Lot No. _____ , Recorded Plat _____
5. Private Claims _____

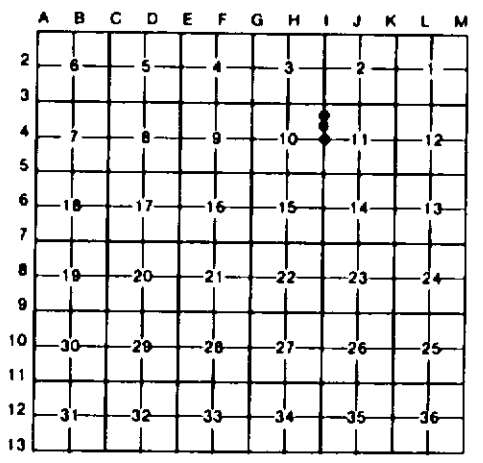

I, Carl R. Johnson, in a field survey on May 13, 19 92, do hereby certify that under requirements of P.A. 74, Michigan P.A. of 1970, the corner points mentioned in lines 1 and 2 above were in conformance with regulations and rules therefore as required in the current manual of survey instructions of the United States Department of the Interior, Bureau of Land Management or by a decree of a Court of Law and/or that the corner points mentioned in lines 3, 4 and 5 above were in conformance with the rules of the Michigan Board of Land Surveyors or by a Decree of a Court of Law; established, re-established, monumented, re-monumented, recovered, found as expressed below:

NOTE: Not more than 4 corners, all in the same town and range, may be recorded on this certificate.

A. Description of original monument and accessories and/or subsequent restoration:

I-4	I-4,7	I-3,7

B. Description of corner evidence found and/or method applied in restoring or reestablishing corner:

I-4	I-4,7	I-3,7
Found iron in place and accepted as the true position for restoration.	Set on line between sections 10/11 on right bank of Thunder Bay River. Original meander corner falls in stream.	Set on line between sections 10/11 on right bank of Thunder Bay River. Original meander corner would fall 7.14 feet southerly in river. Corner is S06-25-25E, 494.55 feet from the NE corner of section 10, which is in river.

C. Description of monument for corner and accessories established to perpetuate locating the position of the corner:

I-4	I-4,7	I-3,7
E1/4 cor. sec. 10	Witness Corner 10/11	Witness Corner 10/11
Fd. 1" Pipe w/cap #19237	Set DNR Mon.	Set DNR Mon.
14" R.Pine N03W 22.7 ft	Maple clump N54W 40.3 ft	22' Maple Due West 13.9 ft
8" Balsam S09W 22.0 ft	16" Maple S77W 56.9 ft	18" Maple N45E 27.2 ft
8" Balsam S43E 20.4 ft	24" Maple S45E 72.7 ft	5 feet south to right bank of
4" Maple N58E 15.8 ft	4 feet north to right bank of	Thunder Bay River.
	Thunder Bay River.	

STATE OF MICHIGAN
CARL R. JOHNSON
LAND SURVEYOR
No. 30083
LICENSED LAND SURVEYOR

Signed by Carl R. Johnson Date 7/7/92

Surveyor's Michigan License No. 30083

FORM APPROVED BY MICHIGAN STATE BOARD OF LAND SURVEYORS, JAN. 26, 1971
REVISED MAY 14, 1975
REVISED JAN., 1983