

NOV 16 1998

P.A. 345 ALPENA COUNTY

PEER APPROVED 8/10/98
D. T. Kibbe

1998 Alpena County Remonumentation Corner
LAND CORNER RECORDATION CERTIFICATE SECTION
Filing Requirement of Act 74, Mich. P.A. 1970 Liber 000002 Page 0141

For corners in

<u>Alpena</u> (County)	Located In:	Corner Code #
1. Public Land Survey	T 31N R6E	<u>A-3</u> ✓
	T 31N R5E	<u>M-3</u> ✓
	T _____ R _____	_____
	T _____ R _____	_____
2. Property Controlling in Section	S _____ T _____ R _____	_____
	S _____ T _____ R _____	_____
3. Miscellaneous Property in Sec.	S _____ T _____ R _____	_____
	S _____ T _____ R _____	_____

STATE OF MICHIGAN
County of Alpena
Recorded
08-20-1998 09:17:44
Kathy J. Matash
REGISTER OF DEEDS

Register of Deeds Stamp & File Number

4. Lot No. _____, Recorded Plat _____
5. Private Claims _____

I, Daniel T. Kibbe, in a field survey on March 3, 1998 do hereby state that under requirements of P.A. 74, Michigan P.A. of 1970, the corner points mentioned in lines 1 and 2 above were in conformance with regulations and rules therefore as required in the current manual of survey instructions of the United States Department of the Interior, Bureau of Land Management or by a decree of a Court of Law and /or that the corner points mentioned in lines 3, 4 and 5 above were in conformance with the rules of the Michigan Board of Land Surveyors or by a Decree of a Court of Law; established, re-established, monumented, recovered, found as expressed below:

NOTE: Not more than 2 corners, all in the same town and range, may be recorded on this certificate.

A	B	C	D	E	F	G	H	I	J	K	L	M
1												
2	6		5		4		3		2		1	
3												
4	7		8		9		10		11		12	
5												
6	18		17		16		15		14		13	
7												
8	19		20		21		22		23		24	
9												
10	30		29		28		27		26		25	
11												
12	31		32		33		34		35		36	
13												

A. Description of original monument and accessories and/or subsequent restoration:

- 1855: GLO Survey by Butler Ives-set post at corner of sections; referenced: Cedar 5-S66W-3/Cedar 15-N59W-40
- 1901: County Survey by Wm. H. LeRoy-set 3" sq. cedar stake in place of old W.S. survey; referenced: Dead cedar 6-S65W-3 ONBT Cedar Stump 18-N59W-40 2/3 ONBT/W. Pine Stump 36-N88E-99 1/2 NWT/Dead W. Pine 36-N52E-7.71 ch NWT
- 1909: County Survey by Jos. W. McNeil-found old stake standing and both NWT stumps plain. Set new cedar stake and made NWT; Referenced: Cedar stump 18-S59W-40 ONBT

B. Description of corner evidence found and/or method applied in restoring or reestablishing corner:


- 1998: Remon. Survey by Daniel T. Kibbe-no evidence of corner or fence lines. Set 1/2" rebar 0.6' below surface at single proportionate position from A-2 and A-4. This position is 3' East of CL N-S road and is compatible with 1/8 line fences to the North and South.

This corner position is compatible with county & local surveys. This corner position is accepted as a careful and faithful perpetuation of the position of the original corner.

C. Description of monument for corner and accessories established to perpetuate locating the position of the corner:

- 1998: Placed 3" Alpena County cap stamped to identify the corner over 1/2" iron rod.
Referenced:
Set tag in Power Pole S12E-145.04'
Set tag in Fence Post N82E-26.35'
Set tag in 10" Twin Balsam N45W-30.25'
Set tag in 4" Poplar S55W-47.60'

Signed by *Daniel T. Kibbe*
Surveyor's Michigan License No. 37278

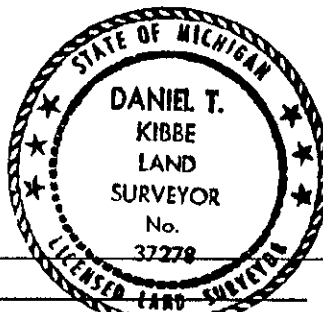

Date August 14, 1998