

**SURVEY &  
REMONUMENTATION**

NOV 16 1998

**P.A. 345 ALPENA COUNTY**  
**PEER APPROVED** *8/14/98*  
*Del B. Kibbe*

**1998 Alpena County Remonumentation Corner**  
**LAND CORNER RECORDATION CERTIFICATE** SECTION  
Filing Requirement of Act 74, Mich. P.A. 1970 Liber **00002** Page **0142**

For corners in

<u>Alpena</u> (County)	Located In:	Corner Code #
1. Public Land Survey	T <u>31N</u> R <u>6E</u>	<u>A-4</u> ✓
	T <u>31</u> R <u>5E</u>	<u>M-4</u> ✓
	T _____ R _____	_____
	T _____ R _____	_____
2. Property Controlling in Section	S _____ T _____ R _____	_____
	S _____ T _____ R _____	_____
3. Miscellaneous Property in Sec.	S _____ T _____ R _____	_____
	S _____ T _____ R _____	_____

STATE OF MICHIGAN  
County of Alpena  
Recorded  
08-20-1998 09:17:57  
Kathy J. Matash  
REGISTER OF DEEDS

Register of Deeds Stamp & File Number

4. Lot No. \_\_\_\_\_, Recorded Plat \_\_\_\_\_  
5. Private Claims \_\_\_\_\_

I, Daniel T. Kibbe, in a field survey on March 3, 1998 do hereby state that under requirements of P.A. 74, Michigan P.A. of 1970, the corner points mentioned in lines 1 and 2 above were in conformance with regulations and rules therefore as required in the current manual of survey instructions of the United States Department of the Interior, Bureau of Land Management or by a decree of a Court of Law and /or that the corner points mentioned in lines 3, 4 and 5 above were in conformance with the rules of the Michigan Board of Land Surveyors or by a Decree of a Court of Law; established, re-established, monumented, recovered, found as expressed below:

A	B	C	D	E	F	G	H	I	J	K	L	M
1												
2	6		5		4		3		2		1	
3												
4	7		8		9		10		11		12	
5												
6	18		17		16		15		14		13	
7												
8	19		20		21		22		23		24	
9												
10	30		29		28		27		26		25	
11												
12	31		32		33		34		35		36	
13												

**NOTE:** Not more than 2 corners, all in the same town and range, may be recorded on this certificate.

**A. Description of original monument and accessories and/or subsequent restoration:**

- 1855: GLO Survey by Butler Ives-set 1/4 section post; referenced: Cedar 7-N74E-9/Cedar 7-S81W-9
- 1909: County Survey by Jos. W. McNeil-found corner plain old stake and two N.B.T. & standing. Set new cedar stake and made NWT Referenced: W. Pine Stump 11-S31 W-54 1/2/B. Ash 5-S81-30E-41
- 1990: Survey by Earl T. Lewis-set R.R. Spike; referenced: P.Pole-N25E-125.2'/18" Aspen-S40E-88.1'
- 1990: Survey by Earl T. Lewis-existing R.R. Spike; referenced: P.Pole-N25E-125.2' 18" Aspen-S40E-88.1'

**B. Description of corner evidence found and/or method applied in restoring or reestablishing corner:**

- 1998: Remon. Survey by Daniel T. Kibbe-no corner found. Set 1/2" rebar 0.6' below surface retracing the 1990 Lewis Survey using a found 33' R.O.W. iron 833' South of corner position. This position fits the one remaining Lewis witness. Corner is 1' east of N.S. CL and is 4' North of fence to West.


This corner position is compatible with county & local surveys. This corner position is accepted as a careful and faithful perpetuation of the position of the original corner.

**C. Description of monument for corner and accessories established to perpetuate locating the position of the corner:**

- 1998: Placed 3" Alpena County cap stamped to identify the corner over 1/2" iron rod.

Referenced:  
Set tag over nail in 18" Aspen S35E-87.96'  
Set tag in Power pole N80E-34.93'  
Set tag in 4" Aspen N50W-31.78'  
Set tag in 3" Balsam S30W-58.13'

Signed by *Daniel T. Kibbe*  
Surveyor's Michigan License No. 37278

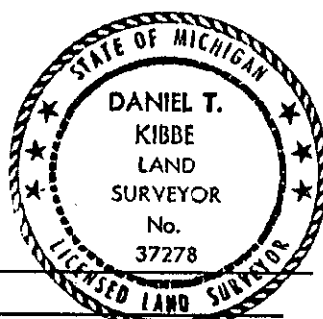

Date August 14, 1998