

LAND CORNER RECORDATION CERTIFICATE

Filing Requirement of Act 74, Mich. PA 1970

For Corners in: Alpena (County)	Located in	Corner Code #
1. Public Land Survey	T _____ R _____	_____
2. Property Controlling in Section	S 12 T 31N R 6E	10
	S 12 T 31N R 6E	15
3. Miscellaneous Property in Section	S _____ T _____ R _____	_____
	S _____ T _____ R _____	_____


Register of Deeds Stamp & File Number

4. Lot No. _____ Recorded Plot: _____

5. Private Claims: _____

I, Carl T. Kiskila, in a field survey on June 21, 2003 do hereby state that under requirements of PA 74, Michigan PA of 1970, the corner points mentioned in lines 1 and 2 above were in conformance with regulations and rules therefore as required in the current manual of survey instructions of the United States Department of the Interior, Bureau of Land Management or by a Decree of a Court of Law and/or that the corner points mentioned in lines 3, 4 and 5 above were in conformance with the rules of the Michigan Board of Land Surveyors or by a Decree of a Court of Law established, re-established, monumented, recovered, found as expressed below.

NOTE: Not more than 2 corners, all in the same town and range, may be recorded on this certificate.

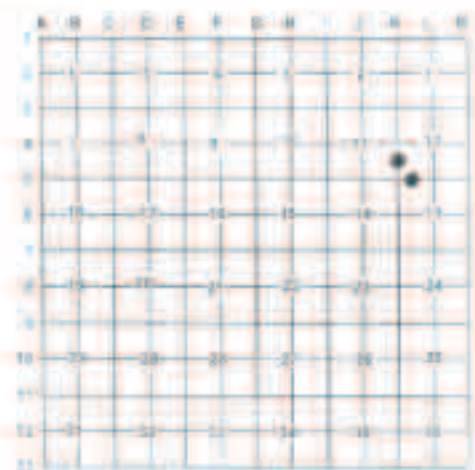

A. Description of original monument and accessories and/or subsequent restoration

10-R.S. Scott 1962 survey shows he found 4" stake and placed 1" Pipe.	15 - Liber 2, Page 344 October 1962 James Scott placed a 3" Cedar stake from Wm. LeRoy 1844 notes
Earl T. Lewis 1985 survey shows he found 1" pipe for corner	

B. Description of corner evidence found and/or method applies in restoring or re-establishing corner

10- Found 1" Pipe fitting Earl T. Lewis's survey in section 12	15- Established the Southwest corner of the Southeast quarter of the Southwest quarter of section 12 as per R.L.M. instruction for the subdivision of a section.
--	--

C. Description of monument for corner and accessories established to perpetuate (locating the position of the corner)

10- 1" pipe Wc T Maple N20°W 11.02 8' Spruce West 30.92 12' Oak S54°E 26.11 14' Twin Oak N56°E 47.60 Carstone Post North 1±	15- Set 1" X 48" pipe with P.S. cap #33981 Wc 12' Cedar 902°E 20.75 6' Maple S77°W 26.09 5' Spruce North 25.25 12' Cedar East 2.95 Fd. rotten cedar stake N10°W 32.7± Carstone Post North 1±
--	--

Signed by: Carl T. Kiskila
 Surveyor's Michigan License No. 33981

Date: 3-22-04

