

# LAND CORNER RECORDATION CERTIFICATE

Filing Requirement of Act 74, Mich. PA 1970


For Corners in:  
Alpena \_\_\_\_\_ Located in \_\_\_\_\_ Corner Code # \_\_\_\_\_  
(County)

- |                                      |                      |         |         |       |   |
|--------------------------------------|----------------------|---------|---------|-------|---|
| 1. Public Land Survey                | T _____              | R _____ |         |       |   |
|                                      | T _____              | R _____ |         |       |   |
| 2. Property Controlling in Section   | S. 23                | T       | 31N     | R. 8E | E |
|                                      | S. 23                | T       | 31N     | R. 8E | 2 |
| 3. Miscellaneous Property in Section | S. _____             | T _____ | R _____ |       |   |
|                                      | S. _____             | T _____ | R _____ |       |   |
| 4. Lot No. _____                     | Recorded Plat: _____ |         |         |       |   |
| 5. Private Claims _____              |                      |         |         |       |   |

Register of Deeds Stamp & File Number

I, Carl T. Kiskila, in a field survey on May 7, 2002 do hereby state that under requirements of PA 74, Michigan PA of 1970, the corner points mentioned in lines 1 and 2 above were in conformance with regulations and rules therefore as required in the current manual of survey instructions of the United States Department of the Interior, Bureau of Land Management or by a decree of a Court of Law and/or that the corner points mentioned in lines 3, 4 and 5 above were in conformance with the rules of the Michigan Board of Land Surveyors or by a Decree of a Court of Law established, re-established, monumented, recovered, found as expressed below.

**NOTE:** Not more than 2 corners, all in the same town and range, may be recorded on this certificate.

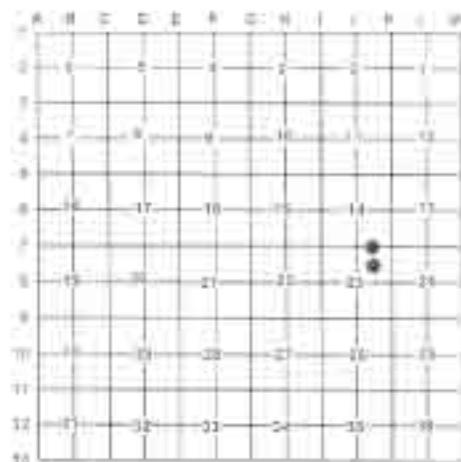

**A. Description of original monument and accessories and/or subsequent restoration**

- |  |  |
|--|--|
| 6- This corner position was not established during the original government survey. | 2- This corner position was not established during the original government survey. |
|--|--|

**B. Description of corner evidence found and/or method applies in restoring or re-establishing corner**

- |   |   |
|---|---|
| 6- Established the Northwest corner of the Southeast quarter of the Northeast quarter of section 23 per standard B.L.M. instructions for the subdivision of a section | 2- Established the Northwest corner of the Northeast quarter of the Northeast quarter of section 23 per standard B.L.M. instructions for the subdivision of a section |
|---|---|

**C. Description of monument for corner and accessories established to perpetuate locating the position of the corner**

- |  |  |
|--|--|
| 6- Set a 5/8" X 32" iron rod with P.S. cap #33981<br>Wit 8" W Pine N85°W 13.82'<br>5" Twin Apple N08°E 38.72'<br>7" W Pine S70°E 63.19'<br>4" R. Pine S03°E 99.98'<br>1/2" CIR #19237 N38°E 1.60'<br>Carsonite Post North 1± | 2- Set 5/8" X 32" iron rod with P.S. cap #33981<br>Wit 6" Twin Maple S59°E 23.71'<br>10" W Pine S50°W 46.83'<br>P. Pole N49°W 39.67'<br>14" W Pine N45°E 58.89'<br>Carsonite Post East 10± |
|--|--|

Signed by Carl T. Kiskila  
Surveyor's Michigan License No.: 33981

Date: 3-22-04

