

# LAND CORNER RECORDATION CERTIFICATE


Filing Requirement of Act 74, Mich. PA 1970

For Corners In:			
Alpena	Located In	Corner Code #	
(County)			
1. Public Land Survey	T <u>31N</u> R <u>6E</u>	<u>I-1</u>	
	T <u>31N</u> R <u>6E</u>	<u>H-1</u>	
2. Property Controlling in Section	S _____ T _____ R _____	_____	
	S _____ T _____ R _____	_____	
3. Miscellaneous Property in Section	S _____ T _____ R _____	_____	
	S _____ T _____ R _____	_____	
4. Lot No: _____	Recorded Plat: _____		
5. Private Claims: _____			

Register of Deeds Stamp & File Number

I, Carl T. Kiiskila, in a field survey on, May 27, 2003 do hereby state that under requirements of PA 74, Michigan PA of 1970, the corner points mentioned in lines 1 and 2 above were in conformance with regulations and rules therefore as required in the current manual of survey instructions of the United States Department of the Interior, Bureau of Land Management or by a decree of a Court of Law and/or that the corner points mentioned in lines 3, 4 and 5 above were in conformance with the rules of the Michigan Board of Land Surveyors or by a Decree of a Court of Law; established, re-established, monumented, recovered, found as expressed below:

**NOTE: Not more than 2 corners, all in the same town and range, may be recorded on this certificate.**

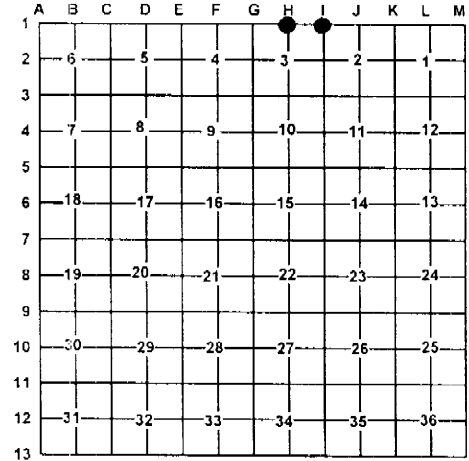

**A. Description of original monument and accessories and/or subsequent restoration:**

- |   |   |
|---|---|
| <p>I-1 G.L.O. Lewis Clawson 1839 Set post corner<br/>                 Wit: Hemlock 20 N68°E 26.1 links<br/>                 Hemlock 24 N50°W 31 links<br/>                 Hemlock 15 S35°E 14 links<br/>                 Hemlock 15 S26°W 24 links</p> <p>Liber 1, page 7 Don Marlatt 1971, Found 1/2" rod<br/>                 Wit: 18" Poplar N60°W 97.0'<br/>                 18" Elm N34°W 61.0'<br/>                 2" Birch S53°W 57.1'</p> <p>Liber 1, page 147 Ronald Bisher 1981, found 1/2" pipe<br/>                 Wit: 8" W. Pine S44°E 66.33'<br/>                 East gate post S02°W 26.89'<br/>                 Old elm stump scribed "BY" N33°W 70.50'<br/>                 9" Birch S41°W 62.96'</p> | <p>H-1 G.L.O. Lewis Clawson 1839 Old quarter section post<br/>                 Wit: Hemlock 12 N19E 5 links<br/>                 Hemlock 8 N22W 21 links</p> <p>Wm. LeRoy 1893 Re-established original 1/4 corner set 3" cedar stake in the hole where old stake stood.<br/>                 Wit: W. Pine 28 S78°E 34 links<br/>                 W. Pine 36 N03°W 59.5 links</p> <p>Liber 1, page 7 Don Marlatt 1971 set 3/8" rered and R.L.S. cap #18660<br/>                 Wit: 6" Poplar N60°E 33.0'<br/>                 7" Maple S35°E 74.05'<br/>                 18" Beech S15°W 30.0'<br/>                 20" Maple S45°W 61.4'</p> <p>Liber 1, page 145, 1981 Ronald Bisher P.S. #22428 Found 1 1/2" pipe buried 8"<br/>                 Wit: 18" Beech S55°W 61.82'<br/>                 20" Maple S31°W 30.47'<br/>                 6" Maple S37°E 74.25'</p> |
|---|---|

**B. Description of corner evidence found and/or method applies in restoring or re-establishing corner:**

- |                   |   |
|-------------------|---|
| I-1 Found 2" Pipe | H-1 Found 1/2" rod with P.S. Cap #31591 |
|-------------------|---|

**C. Description of monument for corner and accessories established to perpetuate locating the position of the corner:**

- |   |  |
|---|--|
| <p>I-1 2" Pipe<br/>                 Wit: Fence Post N34°W 64.08'<br/>                 7" R. Pine S89°W 70.96'<br/>                 9" Twin Birch S44°W 62.70'<br/>                 24" W. Pine S42°E 66.43'</p> | <p>H-1 1/2" rod w/ P.S. cap #31591<br/>                 Wit: Fence Post w/ tag P.S. 31591 N59°W 32.66'<br/>                 Fence Post w/ tag P.S. 31591 S44°W 20.51'<br/>                 Fence post w/ tag P.S. 31591 N01°E 52.24'<br/>                 8" Maple clump S32°E 73.94'<br/>                 Centerline of E-W road South 3'</p> |
|---|--|

Signed by: Carl T. Kiiskila  
 Surveyor's Michigan License No.: 33981

Date: 3-22-04

