

# LAND CORNER RECORDATION CERTIFICATE

Filing Requirement of Act 74, Mich. PA 1970

For Corners In:			
Alpena	Located In	Corner Code #	
(County)			
1. Public Land Survey	T 31N R 6E	L-9	
	T 31N R 6E	M-9	
2. Property Controlling in Section	S T R		
	S T R		
3. Miscellaneous Property in Section	S T R		
	S T R		


Register of Deeds Stamp & File Number

4. Lot No: \_\_\_\_\_ Recorded Plat: \_\_\_\_\_

5. Private Claims: \_\_\_\_\_

I, Carl T. Kiiskila, in a field survey on, June 4, 2003 do hereby state that under requirements of PA 74, Michigan PA of 1970, the corner points mentioned in lines 1 and 2 above were in conformance with regulations and rules therefore as required in the current manual of survey instructions of the United States Department of the Interior, Bureau of Land Management or by a decree of a Court of Law and/or that the corner points mentioned in lines 3, 4 and 5 above were in conformance with the rules of the Michigan Board of Land Surveyors or by a Decree of a Court of Law; established, re-established, monumented, recovered, found as expressed below:

**NOTE: Not more than 2 corners, all in the same town and range, may be recorded on this certificate.**

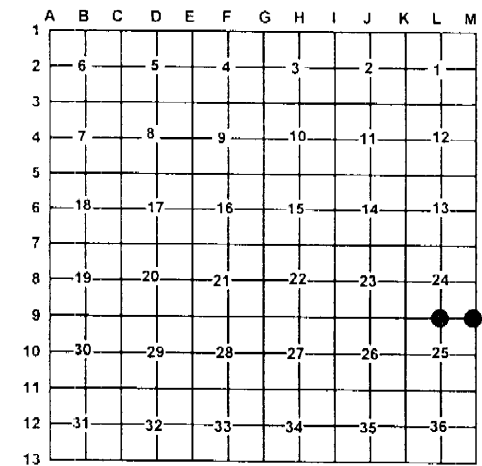

**A. Description of original monument and accessories and/or subsequent restoration:**

L-9 G.L.O. Butler Ives 1855 Set quarter section post  
 Wit: Cedar 13" S09°W 36 links  
 Hemlock 16" N46°E 7 links

M-9 G.L.O Butler Ives 1855 set post corner of section 24 and 25.  
 Wit: Birch 10" S50°W 30 links  
 Cedar 7" N64°W 23 links

Page 5, Michigan State Highway Department, 1930, project No. M04-13 plans shows this quarter corner common to 24 and 25 is 38.6' east of Pl#2.

David B. Guthrie P.S. #22435 Certificate of Survey shows he found an existing iron stake in a Monument Box.  
 No witnesses given.

Thomas L. Fabis 1994 certificate of Survey shows he found an existing R.R. spike for corner.  
 Wit: R. Pine N80°E 72.46'  
 P. P. S45°E 52.35'  
 Tele. Pole S40°E 34.50'  
 Tele. Pole N80°W 115.00'

**B. Description of corner evidence found and/or method applies in restoring or re-establishing corner:**

L-9 Found railroad spike otop of 1/2" pipe in the Centerline of Harrison Road and Kaiser Road.

M-9 Found a 1/2" rod in a monument box fitting D. B. Guthrie's Certificate of Survey.

**C. Description of monument for corner and accessories established to perpetuate locating the position of the corner:**

L-9 Railroad spike otop of 1/2" pipe  
 Wit: 8" R. Pine S87°E 72.45'  
 P. Pole w/ MDOT tag S34°E 52.50'  
 Wooden post w/ MDOT tag N10°W 44.38'  
 P. Poie N75°W 114.92'  
 1" Axel Shaft S88°W 39.04'  
 Fd. 1/2" Pipe S89°E 3.18'

M-9 Added a P.S. cap #33981 to the found 1/2" rod.  
 Wit: 8" Balsam S06°E 34.88'  
 \*10" Balsam w/ Fabis tag S30°E 35.58'  
 P. Pole N65°W 128.45'  
 6" Maple Clump N27°E 103.73'

Signed by: Carl T. Kiiskila  
 Surveyor's Michigan License No.: 33981

Date: 3-22-04

