

DEC 07 1994

1994 Alpena County Remonumentation Corner

COMMISSION

LAND CORNER RECORDATION CERTIFICATE

Filing Requirement of Act 74, Mich. P.A. 1970

RECORDED ALPENA COUNTY MI.

LIBER 1 PAGE 311
OCT 11 10 38 AM '94

Myra A. Johnson
REGISTER OF DEEDS

For corners in

Alpena (County)	Located In:	Corner Code #
1 Public Land Survey	T 31N R 7E	A-9
	T ___ R ___	_____
	T ___ R ___	_____
	T ___ R ___	_____
2 Property Controlling in Section	S ___ T ___ R ___	_____
	S ___ T ___ R ___	_____
3 Miscellaneous Property in Sec.	S ___ T ___ R ___	_____
	S ___ T ___ R ___	_____
4 Lot No. _____	Recorded Plat _____	
5 Private Claims _____		

Register of Deeds Stamp & File Number

I, Daniel T. Kibbe, in a field survey on May 24, 19 94, do hereby certify that under requirements of P.A. 74, Michigan P.A. of 1970, the corner points mentioned in lines 1 and 2 above were in conformance with regulations and rules therefore as required in the current manual of survey instructions of the United States Department of the Interior, Bureau of Land Management or by a decree of a Court of Law and/or that the corner points mentioned in lines 3, 4 and 5 above were in conformance with the rules of the Michigan Board of Land Surveyors or by a Decree of a Court of Law; established, re-established, monumented, re-monumented, recovered, found as expressed below:

	A	B	C	D	E	F	G	H	I	J	K	L
2	6	5	4	3	2	1						
3												
4	7	8	9	10	11	12						
5												
6	18	17	16	15	14	13						
7												
8	19	20	21	22	23	24						
9												
10	30	29	28	27	26	25						
11												
12	31	32	33	34	35	36						
13												

NOTE: Not more than 4 corners, all in the same town and range, may be recorded on this certificate.

A. Description of original monument and accessories and/or subsequent restoration:

- 1855: G.L.O., Re-survey by Butler Ives - set post & referenced: Cedar 5 - S 42 E - 3 1/2' / Cedar 8 - N 08 E 34.
- 1893: Range Line Survey by Fred A. Rice - fnd. stake, set new cedar stake.
- 1914: County Survey by Jos. W. McNeil - referenced.
- 1958: Survey by G. Jerome & Co.
- 1961: Monument Witness Record by N.C. Caldwell - fnd. cabin spike at position indicated on old highway plans & referenced.
- 1963: MSHD Construction Plans - fnd. old cabin spike & referenced.
- 1968: MSHD - Rewitnessed 1/2" iron rod.
- 1986: Survey by G. Jerome & Co.

B. Description of corner evidence found and/or method applied in restoring or reestablishing corner:


- 1994: Found 1/2" iron bar in monument box.

This corner position is compatible with county and local surveys and agrees with MDOT records. This corner position is accepted as a careful and faithful perpetuation of the position of the original corner.

P.A. 345 ALPENA COUNTY
PEER APPROVED Sept. 4, 1994
D. B. Lutz

C. Description of monument for corner and accessories established to perpetuate locating the position of the corner:

- 1994: Placed 3" aluminum cap stamped to identify the corner over existing 1/2" iron rod in monument box.
- Referenced:
 - S 27° W - fnd. nail & tag in T. pole - 77.78'
 - N 35° W - SE cor. stone hse. - 177.64'
 - N 23° E - set nail in 14" W. Pine - 182.62'
 - S 51° E - set nail in T. pole - 103.43'

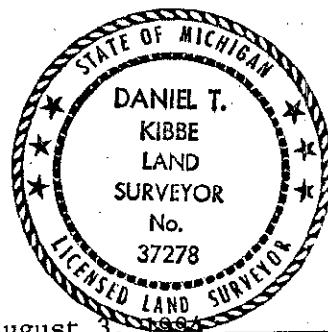

Signed by *Daniel T. Kibbe*

Date August 3, 1994

Surveyor's Michigan License No. 37278