

SURVEY & REMONUMENTATION

1994 ^{DEC 07 1994} Alpena County Remonumentation Corner

COMMISSION

LAND CORNER RECORDATION CERTIFICATE
Filing Requirement of Act 74, Mich. P.A. 1970

RECORDED
ALPENA COUNTY MI
LIBER 1 PAGE 312
OCT 11 10 38 AM '94
Mary A. Johnston
REGISTER OF DEEDS

For corners in

| Alpena (County) | Located In: | Corner Code # |
|--------------------------------------|-------------------------|---------------|
| 1 Public Land Survey | T 31N R 7E | B-9 |
| | T _____ R _____ | _____ |
| | T _____ R _____ | _____ |
| | T _____ R _____ | _____ |
| 2 Property Controlling in Section | S _____ T _____ R _____ | _____ |
| | S _____ T _____ R _____ | _____ |
| 3 Miscellaneous Property in Sec. | S _____ T _____ R _____ | _____ |
| | S _____ T _____ R _____ | _____ |

Register of Deeds Stamp & File Number

4 Lot No. _____, Recorded Plat _____
5 Private Claims _____

| | A | B | C | D | E | F | G | H | I | J | K | L | M |
|----|----|---|----|---|----|---|----|---|----|---|----|---|---|
| 2 | 6 | | 5 | | 4 | | 3 | | 2 | | 1 | | |
| 3 | | | | | | | | | | | | | |
| 4 | 7 | | 8 | | 9 | | 10 | | 11 | | 12 | | |
| 5 | | | | | | | | | | | | | |
| 6 | 18 | | 17 | | 16 | | 15 | | 14 | | 13 | | |
| 7 | | | | | | | | | | | | | |
| 8 | 19 | | 20 | | 21 | | 22 | | 23 | | 24 | | |
| 9 | ● | | | | | | | | | | | | |
| 10 | 30 | | 29 | | 28 | | 27 | | 26 | | 25 | | |
| 11 | | | | | | | | | | | | | |
| 12 | 31 | | 32 | | 33 | | 34 | | 35 | | 36 | | |
| 13 | | | | | | | | | | | | | |

I, Daniel T. Kibbe, in a field survey on May 24 19 94
do hereby certify that under requirements of P.A. 74, Michigan P.A. of 1970, the corner points mentioned in lines 1 and 2 above were in conformance with regulations and rules therefore as required in the current manual of survey instructions of the United States Department of the Interior, Bureau of Land Management or by a decree of a Court of Law and/or that the corner points mentioned in lines 3, 4 and 5 above were in conformance with the rules of the Michigan Board of Land Surveyors or by a Decree of a Court of Law; established, re-established, monumented, re-monumented, recovered, found as expressed below:

NOTE: Not more than 4 corners, all in the same town and range, may be recorded on this certificate.

- A. Description of original monument and accessories and/or subsequent restoration:
- 1855: G.L.O. Re-survey by Butler Ives - set post & referenced: W. Birch 12 - S 6 E - 14 / W. Birch 13 - N 38 W - 9
 - 1958: Survey by G. Jerome & Co.
 - 1961: Monument Witness Record by N.C. Caldwell - set 1" pipe at location shown by G. Jerome & Co. and referenced.
 - 1963: MSHD Construction Plans - found 1" pipe and referenced.
 - 1968: MSHD - rewitnessed 1/2" iron rod.

B. Description of corner evidence found and/or method applied in restoring or reestablishing corner:

1994: Found 1/2" iron bar in monument box.


This corner position is compatible with local surveys and agrees with MDOT records. This corner position is accepted as a careful and faithful perpetuation of the position of the original corner.

P.A. 345 ALPENA COUNTY
PEER APPROVED Sept. 8, 1994
Daniel B. Kibbe

C. Description of monument for corner and accessories established to perpetuate locating the position of the corner:

1994: Placed 3" aluminum cap stamped to identify the corner over existing 1/2" iron rod in monument box.

- Referenced:
- S 23° W - center of old cut-off T. pole - 75.32'
 - S 22° W - set nail in T. pole - 76.21'
 - S 55° E - set nail in T. pole - 133.17'
 - N 64° W - set nail in power pole - 117.40'
 - N 75° E - set nail in power pole - 158.30'

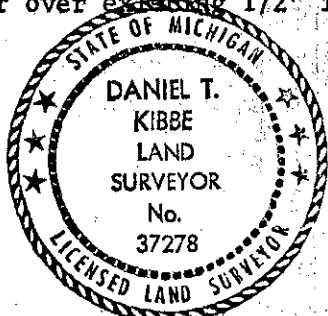

Signed by *Daniel T. Kibbe*

Date August 3, 1994

Surveyor's Michigan License No. 37278