

**SURVEY & REMONUMENTATION**

RECORDED  
ALPENA COUNTY MI.

DEC 07 1994  
1994 Alpena County Remonumentation Corner

LIBER OCT 11 10 38 AM '94  
PAGE 309

COMMISSION

**LAND CORNER RECORDATION CERTIFICATE**  
Filing Requirement of Act 74, Mich. P.A. 1970

*Myron D. Johnston*  
REGISTER OF DEEDS

For corners in:

<u>Alpena</u> (County)	Located In:	Corner Code #
1 Public Land Survey	T <u>31N</u> R <u>7E</u>	<u>F-9</u>
	T _____ R _____	_____
	T _____ R _____	_____
	T _____ R _____	_____
2 Property Controlling in Section	S _____ T _____ R _____	_____
	S _____ T _____ R _____	_____
3 Miscellaneous Property in Sec.	S _____ T _____ R _____	_____
	S _____ T _____ R _____	_____
4 Lot No. _____	Recorded Plat _____	
5 Private Claims _____		

Register of Deeds Stamp & File Number

I, Daniel T. Kibbe, in a field survey on May 24, 19 94, do hereby certify that under requirements of P.A. 74, Michigan P.A. of 1970, the corner points mentioned in lines 1 and 2 above were in conformance with regulations and rules therefore as required in the current manual of survey instructions of the United States Department of the Interior, Bureau of Land Management or by a decree of a Court of Law and/or that the corner points mentioned in lines 3, 4 and 5 above were in conformance with the rules of the Michigan Board of Land Surveyors or by a Decree of a Court of Law; established, re-established, monumented, re-monumented, recovered, found as expressed below:

A	B	C	D	E	F	G	H	I	J	K	L	M
2	6	5	4	3	2	1						
3												
4	7	8	9	10	11	12						
5												
6	18	17	16	15	14	13						
7												
8	19	20	21	22	23	24						
9												
10	30	29	28	27	26	25						
11												
12	31	32	33	34	35	36						
13												

NOTE: Not more than 4 corners, all in the same town and range, may be recorded on this certificate.

A Description of original monument and accessories and/or subsequent restoration:

- 1855: G.L.O. Re-survey by Butler Ives - set post and referenced: B. Ash 18 - N 31 W - 9 / Maple 14 - S 36 E - 15
- 1961: Monument Witness Record by N.C. Caldwell - set 1/2" iron bar at position indicated on old highway plans and referenced.
- 1963: MSHD Construction Plans - referenced 1/2" iron bar.
- 1968: MSHD - rewitnessed 1/2" iron rod.

B Description of corner evidence found and/or method applied in restoring or reestablishing corner:


1994: Found 1/2" iron bar in monument box.

This corner position agrees with MDOT records and is accepted as a careful and faithful perpetuation of the position of the original corner.

P.A. 345 ALPENA COUNTY  
PEER APPROVED Sept. 8, 1994  
*Paul B. White*

C Description of monument for corner and accessories established to perpetuate locating the position of the corner:

- 1994: Placed 3" aluminum cap stamped to identify the corner over existing 1/2" iron rod in monument box.
- Referenced:
  - S 35° W - set nail over scar in 16" Maple - 87.77'
  - S 02° W - set nail in 12" Ash - 123.52'
  - N 05° E - set nail in power pole - 123.90'
  - N 05° E - set nail in 14" Cedar - 80.26'

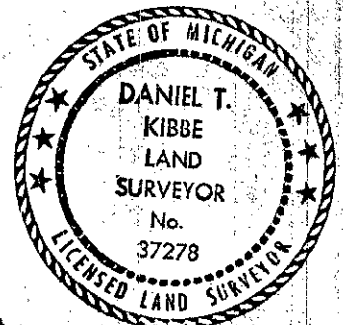

Signed by *Daniel T. Kibbe*

Date August 3, 1994

Surveyor's Michigan License No. 37278