

SURVEY & REMONUMENTATION

1994, Alpena County Remonumentation Corner
 DEC 07 1994

LAND CORNER RECORDATION CERTIFICATE
 Filing Requirement of Act 74, Mich. P.A. 1970


RECORDED
 ALPENA COUNTY, MI.
 LIBER 1 PAGE 308
 OCT 11 10 38 AM '94
Myriam A. Johnston
 REGISTER OF DEEDS

For corners in **COMMISSION**

Alpena (County)	Located In:	Corner Code #
1. Public Land Survey	T <u>31N</u> R <u>7E</u>	<u>G-9</u>
	T _____ R _____	_____
	T _____ R _____	_____
	T _____ R _____	_____
2. Property Controlling in Section	S _____ T _____ R _____	_____
	S _____ T _____ R _____	_____
3. Miscellaneous Property in Sec.	S _____ T _____ R _____	_____
	S _____ T _____ R _____	_____
4. Lot No. _____, Recorded Plat _____		
5. Private Claims _____		

Register of Deeds Stamp & File Number

I, Daniel T. Kibbe, in a field survey on June 9, 19 94, do hereby certify that under requirements of P.A. 74, Michigan P.A. of 1970, the corner points mentioned in lines 1 and 2 above were in conformance with regulations and rules therefore as required in the current manual of survey instructions of the United States Department of the Interior, Bureau of Land Management or by a decree of a Court of Law and/or that the corner points mentioned in lines 3, 4 and 5 above were in conformance with the rules of the Michigan Board of Land Surveyors or by a Decree of a Court of Law; established, re-established, monumented, re-monumented, recovered, found as expressed below:

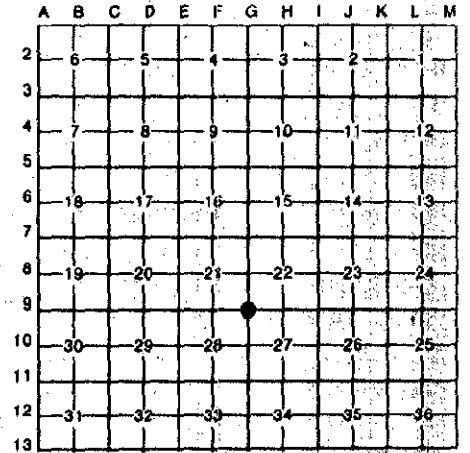

NOTE: Not more than 4 corners, all in the same town and range, may be recorded on this certificate.

A. Description of original monument and accessories and/or subsequent restoration:

- 1855: G.L.O. Re-survey by Butler Ives - set post & referenced: Spruce 12 - N 48 W - 39 / Spruce 5 - S 35 E - 10.
- 1961: Monument Witness Record by N.C. Caldwell - found large cabin spike in position shown on old highway plans & referenced.
- 1963: MSHD Construction Plans - found large cabin spike & referenced.
- 1968: MSHD - Re-witnessed 1/2" iron spike.
- 1968: Survey by James Scott - Seelye's Space Age Sub.
- 1972: Survey by James Scott
- 1976: Survey by David Guthrie - found mon. box.
- 1980: Survey by Duane MacNeill
- 1992: Survey by Earl Lewis - fnd. mon. box & referenced.

B. Description of corner evidence found and/or method applied in restoring or reestablishing corner:

1994: Found 1/2" iron bar in monument box.

This corner position is compatible with local surveys and agrees with MDOT records. This corner position is accepted as a careful and faithful perpetuation of the position of the original corner.


P.A. 345 ALPENA COUNTY
 PEER APPROVED Sept. 8, 1994
Dud B. Carter

C. Description of monument for corner and accessories established to perpetuate locating the position of the corner:

1994: Placed 3" aluminum cap stamped to identify the corner over existing 1/2" iron rod in monument box.

Referenced:

- S 26° W - NE cor. house - 132.0'
- S 22° E - center 6" Maple stump - 79.6'
- S 04° W - set nail in power pole - 87.54'
- S 54° W - fnd. flagged nail in T. pole - 137.44'
- N 00° E - fnd. MSHD nail & tag in power pole - 103.72'

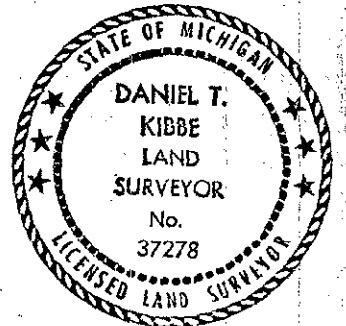

Signed by *Daniel T. Kibbe*

Date August 3, 1994

Surveyor's Michigan License No. 37278