

MAY 1 8 1997

1996 ALPENA COUNTY REMONUMENTATION CORNER

LIBER

2 PAGE 46

COMMISSION

LAND CORNER RECORDATION CERTIFICATE

Filing Requirement of Act 74, Mich. P.A. 1970

For corners in

Alpena (County)

Located In:

Corner Code #

RECORDED ALPENA COUNTY MI.

JUL 22 11 07 AM '96

Handwritten signature

REGISTER OF DEEDS


Register of Deeds Stamp & File Number

- 1. Public Land Survey T 31N R 8E G-3 (SW, 3) ✓ Alpena Twp.
2. Property Controlling in Section S T R
3. Miscellaneous S T R
Property in Section S T R

- 4. Lot No. , Recorded Plat
5. Private Claims

I, Thomas L. Fabis, in a field survey on May 9, 1996, do hereby certify that under requirements of P.A. 74, Michigan P.A. of 1970, the corner points mentioned in lines 1 and 2 above were in conformance with regulations and rules therefore as required in the current manual of survey instructions of the United States Department of the Interior, Bureau of Land Management or by a decree of a Court of Law and/or that the corner points mentioned in lines 3, 4 and 5 above were in conformance with the rules of the Michigan Board of Professional Surveyors or by a Decree of a Court of Law; established, re-established, monumented, re-monumented, recovered, found as expressed below:

NO. Not more than 4 corners, all in the same town and range, may be recorded on this certificate.

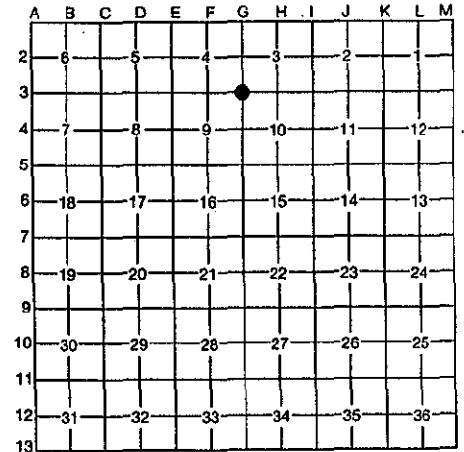


- A. Description of original monument and accessories and/or subsequent restoration:
1855: G.L.O. Resurvey by Josiah Knauer - Set post & referenced: (Hemlock 16 - N50E - 191ks., Spruce 12 - S57W - 23 lks.)
1906: County Survey by Jos. W. McNeil - Visited corner.
1975: Survey(Liber 1 Pages 287&288) by David Guthrie of R.S.Scott Assoc.-1/4" iron & witnessed.
1977: L.C.R.C. (Liber 1 Page 92) by Ron Bischer - 1/4" Rod & witnessed.
1979 and 1985: Surveys(Liber 1 Page 830) & (Liber 2 Page335) by David Guthrie-1/2" iron rod.
1990: Survey(Liber 2 Page 553) & L.C.R.C.(Liber 1 Page 221)by Thomas Fabis-1/2"iron & witnessed.
1991: (W.O.4-1314),1992:(W.O.4-1554)&1993:(W.O.4-2352) Surveys by Earl Lewis-1/2"rod&witnessed.
1995: Road Survey Notes by Rowe Engineering - 1/4" Rod & witnessed.

- B. Description of corner evidence found and/or method applied in restoring or reestablishing corner:
1996: Found iron rod corroded at the surface causing the iron rod to appear to be a 1/4" iron rod. Also, found 3 existing witnesses.

The position of this corner is compatible with county and local surveys and is accepted as a careful and faithful perpetuation of the position of the original corner.

P.A. 345 ALPENA COUNTY PEER APPROVED 5/16/96 [Signature]

- C. Description of monument for corner and accessories established to perpetuate locating the position of the corner:
1996: Removed existing iron rod and set new 1/2" iron rod capped with a 3" dia. aluminum cap, stamped to identify the corner.
Reestablished witnesses are:
23" Cedar - N45E - 53.90'
4" W. Pine - N12E - 46.79'
12" Apple - N74E - 76.83'
P. Pole - S10E - 69.66'

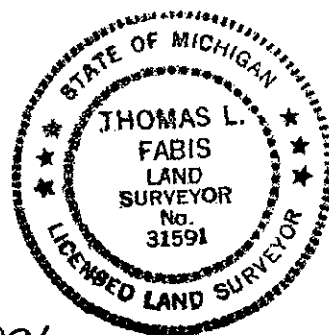

Signed by Thomas L. Fabis

Date July 17, 1996

Surveyor's Michigan License No. 31591