

MAY 16 1997

1996 ALPENA COUNTY REMONUMENTATION CORNER

LIBER

2 PAGE 48

COMMISSION

LAND CORNER RECORDATION CERTIFICATE

Filing Requirement of Act 74, Mich. P.A. 1970

For corners in

Alpena (County)

Located In:

Corner Code #

- 1. Public Land Survey T 31N R 8E H-3 (S1/2, 3) Alpena Twp.
2. Property Controlling in Section S T R
3. Miscellaneous Property in Section S T R

RECORDED ALPENA COUNTY MI.

JUL 22 11 07 AM '96

REGISTER OF DEEDS

Register of Deeds Stamp & File Number

- 4. Lot No. Recorded Plat
5. Private Claims

Grid table with columns A-L and rows 2-13. A dot is marked at the intersection of column H and row 3.

I, Thomas L. Fabis, in a field survey on May 9, 1996, do hereby certify that under requirements of P.A. 74, Michigan P.A. of 1970, the corner points mentioned in lines 1 and 2 above were in conformance with regulations and rules therefore as required in the current manual of survey instructions of the United States Department of the Interior, Bureau of Land Management or by a decree of a Court of Law and/or that the corner points mentioned in lines 3, 4 and 5 above were in conformance with the rules of the Michigan Board of Professional Surveyors or by a Decree of a Court of Law; established, re-established, monumented, re-monumented, recovered, found as expressed below:

NOTE: Not more than 4 corners, all in the same town and range, may be recorded on this certificate.

A. Description of original monument and accessories and/or subsequent restoration:

- 1855: G.L.O. Resurvey by Josiah Knauer - Set post & referenced: (Maple 6 - N9E - 15 lks., Cedar 6 - S41W - 17 lks.)
1977: L.C.R.C. (Liber 1 Page 92) by Ron Bischer-Found 1/2" Pipe/raised with Nail & referenced.
1978: Survey (Liber 1 Page 591) by Delmer Porter - Found 1/2" Pipe/raised with P.K. Nail and referenced.
1979: Survey (W.O.4-5854) by David Guthrie of R.S.Scott Associates - Found 1/2" Pipe/raised with 1/2" iron rod and referenced.
1992: Survey (W.O.4-1551) by Earl Lewis - Existing 1/2" Rod and referenced.
1995: Road Survey Notes by Rowe Engineering - Found 1/2" iron rod and referenced.

B. Description of corner evidence found and/or method applied in restoring or reestablishing corner:


- 1996: Found 1/2" iron rod and the following witnesses: P. Pole with Porter tag - S40W - 54.34', Old Anchor Pole with Lewis tag - N30W - 43.87', Stop Sign - S14E - 64.25'.

The position of this corner is compatible with the local surveys mentioned above and is accepted as a careful and faithful perpetuation of the position of the original corner.

P.A. 345 ALPENA COUNTY, PEER APPROVED 5/16/96 [Signature]

C. Description of monument for corner and accessories established to perpetuate locating the position of the corner:

- 1996: Set 3" dia. aluminum cap, stamped to identify the corner, over the existing 1/2" iron rod.
Reestablished witnesses are:
Existing tag #15410 in P. Pole - S40W - 54.06'
Set tags #31591 in the following witnesses:
New Anchor Pole - N30W - 56.94'
5" Spruce - S40W - 81.80'
2" Spruce - S40E - 56.50'

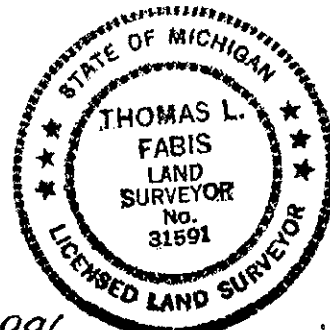

Signed by Thomas L. Fabis

Date July 17, 1996

Surveyor's Michigan License No. 31591