

MAY 18 1997 1996 ALPENA COUNTY REMONUMENTATION CORNER

LIBER 2 PAGE 45

LAND CORNER RECORDATION CERTIFICATE

COMMISSION

Filing Requirement of Act 74, Mich. P.A. 1970

RECORDED
ALPENA COUNTY MI.

For corners in
Alpena
(County)

Located In: Corner Code #

- 1. Public Land Survey T 31N R 8E I-3, (SE, 3)
T _____ R _____ Alpena Twp.
T _____ R _____
T _____ R _____
- 2. Property Controlling S _____ T _____ R _____
in Section S _____ T _____ R _____
- 3. Miscellaneous S _____ T _____ R _____
Property in Section S _____ T _____ R _____

JUL 22 11 07 AM '96

Halley Marsh
REGISTER OF DEEDS

Register of Deeds Stamp & File Number

- 4. Lot No. _____, Recorded Plat _____
- 5. Private Claims _____

A	B	C	D	E	F	G	H	I	J	K	L	M
2	6	5	4	3	2	1						
3								●				
4	7	8	9	10	11	12						
5												
6	18	17	16	15	14	13						
7												
8	19	20	21	22	23	24						
9												
10	30	29	28	27	26	25						
11												
12	31	32	33	34	35	36						
13												

I, Thomas L. Fabis, in a field survey on May 9, 19 96, do hereby certify that under requirements of P.A. 74, Michigan P.A. of 1970, the corner points mentioned in lines 1 and 2 above were in conformance with regulations and rules therefore as required in the current manual of survey instructions of the United States Department of the Interior, Bureau of Land Management or by a decree of a Court of Law and/or that the corner points mentioned in lines 3, 4 and 5 above were in conformance with the rules of the Michigan Board of Professional Surveyors or by a Decree of a Court of Law; established, re-established, monumented, re-monumented, recovered, found as expressed below:

NOTE: Not more than 4 corners, all in the same town and range, may be recorded on this certificate.

A. Description of original monument and accessories and/or subsequent restoration:

- 1855: G.L.O. Resurvey by Josiah Knauer - Set post & referenced: (Beech 6 - S52E - 42 lks., Hemlock 12 - N39W - 19 lks.)
- 1911: County Survey by Jos. W. McNeil - Corner in road bed.
- 1977: Survey (Liber 1 Page 571) by Delmer Porter and L.C.R.C. (Liber 1 Page 92) by Ron Bischer - Found Conc. Mon. & witnessed.
- 1978: Survey (Liber 1 Page 591) by Delmer Porter - Found Conc. Mon. & witnessed.
- 1991: Survey (W.O.4-1314) by Earl Lewis - Existing 1/2" Rod & witnessed.
- 1995: Road Survey Notes by Rowe Engineering - Found Conc. Mon. & witnessed.

B. Description of corner evidence found and/or method applied in restoring or reestablishing corner:

- 1996: Found 60 penny nail over Conc. Monument and all 3 of Rowe Engineerings' witnesses.

The position of this corner is compatible with county and local surveys and is accepted as a careful and faithful perpetuation of the position of the original corner.


P.A. 345 ALPENA COUNTY
PEER APPROVED 5/16/96
Det B

C. Description of monument for corner and accessories established to perpetuate locating the position of the corner:

- 1996: Set 3" dia. aluminum cap, stamped to identify the corner, over the existing concrete monument.

Reestablished witnesses are:

- Found tag in P. Pole - N70E - 69.54'
- Found tag in 20" Maple - N40W - 75.00'
- Set tag #31591 in P. Pole - S45E - 82.05'
- Set tag #31591 in P. Pole - S60W - 74.24'

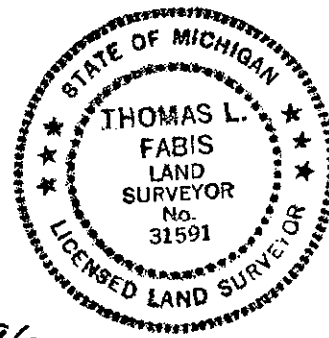

Signed by Thomas L. Fabis

Date July 17, 1996

Surveyor's Michigan License No. 31591