

MAY 16 1997

1996 ALPENA COUNTY REMONUMENTATION CORNER

LIBER 2 PAGE 44

COMPARISON

LAND CORNER RECORDATION CERTIFICATE
Filing Requirement of Act 74, Mich. P.A. 1970

RECORDED ALPENA COUNTY MI.


Form with fields: For corners in (Alpena County), Located In, Corner Code #, 1. Public Land Survey, 2. Property Controlling in Section, 3. Miscellaneous Property in Section, 4. Lot No., 5. Private Claims

JUL 22 11 07 AM '96

Kathy J. Hask
REGISTER OF DEEDS

Register of Deeds Stamp & File Number

I, Thomas L. Fabis, in a field survey on May 9, 1996, do hereby certify that under requirements of P.A. 74, Michigan P.A. of 1970, the corner points mentioned in lines 1 and 2 above were in conformance with regulations and rules therefore as required in the current manual of survey instructions of the United States Department of the Interior, Bureau of Land Management or by a decree of a Court of Law and/or that the corner points mentioned in lines 3, 4 and 5 above were in conformance with the rules of the Michigan Board of Professional Surveyors or by a Decree of a Court of Law; established, re-established, monumented, re-monumented, recovered, found as expressed below:

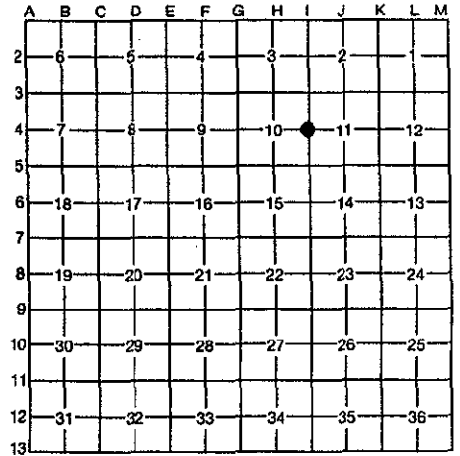

NOTE: Not more than 4 corners, all in the same town and range, may be recorded on this certificate.

A. Description of original monument and accessories and/or subsequent restoration:

- 1855: G.L.O. Resurvey by Josiah Knauer - Set post & referenced: (Birch 5 - N51W - 6 lks., Cedar 7 - East - 5 lks.)
1892: County Survey by Wm. H. LeRoy - Visited corner. Makes tie to I-5.
1978: Survey (Liber 1 Pages 668 and 669) by David Guthrie of R.S. Scott Associates - Found Spike and referenced.


B. Description of corner evidence found and/or method applied in restoring or reestablishing corner:

1996: Found 1/2" iron rod over 3" dia. Metal Plate embedded in concrete 21.50 feet North of the Spike which is described in the 1978 R.S. Scott Survey. The position of this 1/2" iron rod best harmonizes with the existing 1/8 line fences to the North and South and is compatible with the early County Survey by Wm. H. LeRoy. Therefore, its' position is accepted as a careful and faithful perpetuation of the position of the original corner.

P.A. 345 ALPENA COUNTY
PEER APPROVED 5/16/96
D.L.B. [Signature]

C. Description of monument for corner and accessories established to perpetuate locating the position of the corner:

- 1996: Set 3" dia. aluminum cap, stamped to identify the corner, over the existing 1/2" iron rod.
Set tag #31591 in the following reestablished witnesses:
5" Cedar - S30E - 60.30'
Tele. Pole - S75W - 31.91'
3" Twin Cedar - S60W - 45.97'
5" Cedar - N68W - 38.75'

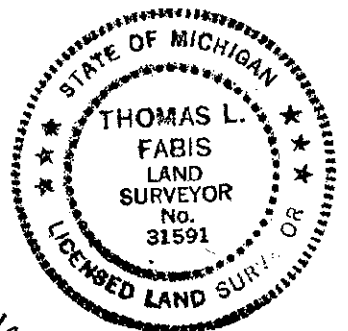

Signed by Thomas L. Fabis

Date July 17, 1996

Surveyor's Michigan License No. 31591