

MAY 13 1997

1996 ALPENA COUNTY REMONUMENTATION CORNER

LIBER 2 PAGE 39

COMMISSION

LAND CORNER RECORDATION CERTIFICATE

Filing Requirement of Act 74, Mich. P.A. 1970

For corners in Alpena (County)

Located In:

Corner Code #

- 1. Public Land Survey T 31NR 8E I-5 (NE, 15) ✓
T _____ R _____
T _____ R _____
T _____ R _____
- 2. Property Controlling S _____ T _____ R _____
in Section S _____ T _____ R _____
- 3. Miscellaneous S _____ T _____ R _____
Property in Section S _____ T _____ R _____

RECORDED ALPENA COUNTY MI.

JUL 22 11 07 AM '96

Kathy G. H. [Signature]
REGISTER OF DEEDS

Register of Deeds Stamp & File Number

- 4. Lot No. _____, Recorded Plat _____
- 5. Private Claims _____

A	B	C	D	E	F	G	H	I	J	K	L	M
2	6	5	4	3	2	1						
3												
4	7	8	9	10	11	12						
5												
6	18	17	16	15	14	13						
7												
8	19	20	21	22	23	24						
9												
10	30	29	28	27	26	25						
11												
12	31	32	33	34	35	36						
13												

I, Thomas L. Fabis, in a field survey on May 9, 1996, do hereby certify that under requirements of P.A. 74, Michigan P.A. of 1970, the corner points mentioned in lines 1 and 2 above were in conformance with regulations and rules therefore as required in the current manual of survey instructions of the United States Department of the Interior, Bureau of Land Management or by a decree of a Court of Law and/or that the corner points mentioned in lines 3, 4 and 5 above were in conformance with the rules of the Michigan Board of Professional Surveyors or by a Decree of a Court of Law; established, re-established, monumented, re-monumented, recovered, found as expressed below:

NOTE: Not more than 4 corners, all in the same town and range, may be recorded on this certificate.

A. Description of original monument and accessories and/or subsequent restoration:

- 1855: G.L.O. Resurvey by Josiah Knauer - Set post & referenced: (Cedar 8 - N21E - 22 lks., Cedar 7 - S44W - 22 lks.)
- 1889: County Survey by Wm. H. LeRoy - Cedar Stake and witnessed.
- 1892: County Survey by Wm. H. LeRoy - Visited corner and witnessed.
- 1978: Survey (Liber 1 Pages 668 and 669) by David Guthrie of R.S. Scott Associates - Found 1" Pipe and set witnesses.
- 1983: Survey (W.O. 4-6374) by David Guthrie - Found 1" Pipe and witnesses.
- 1991: Survey (W.O. 4-8348) by David Guthrie - Found 1" Pipe and set new witnesses.

B. Description of corner evidence found and/or method applied in restoring or reestablishing corner:


1996: Found 1/2" iron rod embedded in concrete 5.65 feet North of the 1" Pipe as described in the 1978, 1983 and 1991 R.S. Scott Surveys. The position of this 1/2" iron rod best harmonizes with the existing 1/8 line fences to the North and South and is compatible with the early County Surveys by Wm. H. LeRoy. Therefore, its' position is accepted as a careful and faithful perpetuation of the original corner.

P.A. 345 ALPENA COUNTY
PEER APPROVED 5/16/96
[Signature]

C. Description of monument for corner and accessories established to perpetuate locating the position of the corner:

1996: Set 3" dia. aluminum cap, stamped to identify the corner, over the existing 1/2" iron rod.

- Reestablished witnesses are:
- 5" Twin Cedar - Due West - 53.27'
 - 9" Cedar - N65W - 40.05'
 - P. Pole - N20E - 72.42'
 - 7" Spruce - N88E - 85.51'

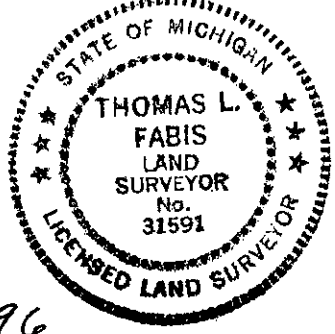

Signed by Thomas L. Fabis

Date July 17, 1996

Surveyor's Michigan License No. 31591