

SURVEY & REMONUMENTATION

1994 ALPENA COUNTY REMONUMENTATION CORNER

007633

APR 06 1995

LAND CORNER RECORDATION CERTIFICATE
Filing Requirement of Act 74, Mich. P.A. 1970

For corners of **Alpena** (County) **COMMISSION**

	Located In:	Corner Code #
1. Public Land Survey	T <u>31N</u> R <u>9E</u>	<u>G-7</u>
	T _____ R _____	_____
	T _____ R _____	_____
	T _____ R _____	_____
2. Property Controlling in Section	S _____ T _____ R _____	_____
	S _____ T _____ R _____	_____
3. Miscellaneous Property in Sec.	S _____ T _____ R _____	_____
	S _____ T _____ R _____	_____
4. Lot No. _____, Recorded Plat _____		
5. Private Claims _____		

RECORDED
 ALPENA COUNTY MI.
 LIBER 1 PAGE 342
 DEC 29 2 20 PM '94
Dominique A. Johnston
REGISTER OF DEEDS

Register of Deeds Stamp & File Number

I, Duane R. MacNeill, in a field survey on May 12, 1994, do hereby certify that under requirements of P.A. 74, Michigan P.A. of 1970, the corner points mentioned in lines 1 and 2 above were in conformance with regulations and rules therefore as required in the current manual of survey instructions of the United States Department of the Interior, Bureau of Land Management or by a decree of a Court of Law and/or that the corner points mentioned in lines 3, 4 and 5 above were in conformance with the rules of the Michigan Board of Land Surveyors or by a Decree of a Court of Law; established, re-established, monumented, re-monumented, recovered, found as expressed below:

	A	B	C	D	E	F	G	H	I	J	K	L	M
2	6	5	4	3	2	1							
3													
4	7	8	9	10	11	12							
5													
6	18	17	16	15	14	13							
7													
8	19	20	21	22	23	24							
9													
10	30	29	28	27	26	25							
11													
12	31	32	33	34	35	36							
13													

NOTE: Not more than 4 corners, all in the same town and range, may be recorded on this certificate.

A. Description of original monument and accessories and/or subsequent restoration:

1856 - Cedar post set by Josiah Knaner, D.S. 1912 - Joseph McNeil set Cedar stake and found one original bearing tree.

Witnesses:

Birch 7" N39°W 24
 Cedar 8" S40°E 33

No Witnesses Supplied

B. Description of corner evidence found and/or method applied in restoring or reestablishing corner:

1976 - D.R. MacNeill & Assoc. find concrete monument. (origin unknown) 1993 - Lewis & Lewis find concrete monument. 1990's - Various Surveyors are into this corner.

No Witnesses Supplied

Witnesses:

N45°W 47.15 Fence Post
 S40°E 46.20 Power Pole
 N10°W 62.45 Stop Sign
 N45°E 70.30 7" Cedar

P.A. 345 ALPENA COUNTY
 PEER APPROVED 12-15-94
D. B. [Signature]


C. Description of monument for corner and accessories established to perpetuate locating the position of the corner:

1994 Remonumentation Crew found concrete monument 6" below and approximately centered on Roadway surface. An Alpena County Aluminum Remonumentation Cap was secured to the re-rod of the existing monument.

Witnesses:

N45°W 46.85 Guy Pole
 N43°E 47.86 Fence Corner
 N45°E 69.37 8" Cedar Stump
 S50°W 68.69 5" Cedar
 S45°E 46.12 P.P.

Signed by *Duane R. MacNeill*
 Surveyor's Michigan License No. 198237

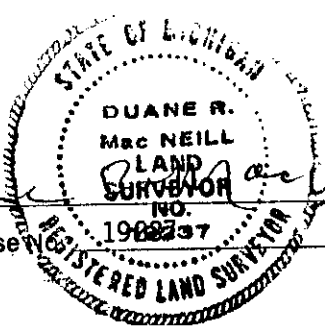

Date 12/20/94