

LAND CORNER RECORDATION CERTIFICATE Filing Requirement of Act 74, Mich. P.A. 1970

For corners in Alpena County (County)

Located In: Corner Code #

Table with 3 columns: Item description, Located In (Township/Range), and Corner Code #. Includes items like Public Land Survey, Property Controlling in Section, and Miscellaneous Property in Sec.


Oct 12 2 12 PM '95

Kathy M. Marsh REGISTER OF DEEDS 005757

Register of Deeds Stamp & File Number

4. Lot No. Recorded Plat 5. Private Claims

I, Earl T. Lewis, in a field survey on May 10, 1995, do hereby certify that under requirements of P.A. 74, Michigan P.A. of 1970, the corner points mentioned in lines 1 and 2 above were in conformance with regulations and rules therefore as required in the current manual of survey instructions of the United States Department of the Interior, Bureau of Land Management or by a decree of a Court of Law and/or that the corner points mentioned in lines 3, 4 and 5 above were in conformance with the rules of the Michigan Board of Land Surveyors or by a Decree of a Court of Law; established, re-established, monumented, re-monumented, recovered, found as expressed below.

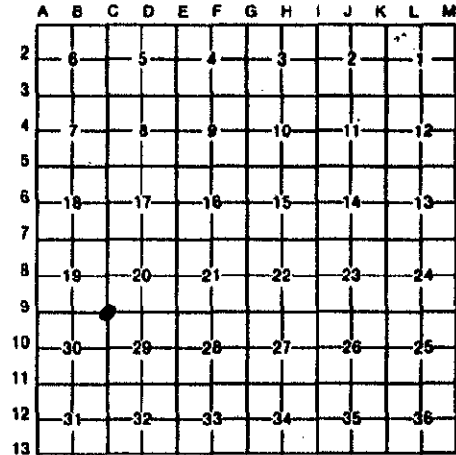

NOTE: Not more than 4 corners, all in the same town and range, may be recorded on this certificate.

A. Description of original monument and accessories and/or subsequent restoration:

AUGUST 23, 1856: GLO Surveyor, Josiah Knauer set post, no monumentation given, witnesses given: Hemlock 20 S 26° E 15, Do 16 N 52° W 43

MAY 12 1894: County Surveyor W. LeRoy, set cedar stake in hole where old stake stood, witnesses given: Hemlock 18 N 52° W 43 (ONBT), Cedar stake 3 S 46° E 70, Cedar stake 4 N 46° W 70

AUGUST 14 1895: County Surveyor W. LeRoy, found cedar stake, witnesses given: Cedar stake 3 S 46° E 70, Cedar stake 4 N 46° W 70

AUGUST 10, 1994: Thomas L. Fabis, P.S. found strong pull, no witnesses given.

B. Description of corner evidence found and/or method applied in restoring or reestablishing corner:

Set 1/2" rerod in intersection of Friski and Truax roads, and in line with an existing fence. The distances to 1/4 corners to the North and South agree closely with county surveyor's notes.

P.A. 345 ALPENA COUNTY PEER APPROVED 9/29/95 [Signature]

C. Description of monument for corner and accessories established to perpetuate locating the position of the corner:

1995, Placed appropriately stamped Alpena County Remonumentation aluminum cap on set 1/2" x 24" rerod, 6" below road surface.

Witnesses:

- N 65° W 141.70' Power Service Pole
N 30° E 43.96' Power Pole
N 15° W 187.30' 18" Poplar
N 80° E 171.40' 36" Cottonwood



Signed by Earl T. Lewis

Date October 8, 1995

Surveyor's Michigan License No. 27452