

LAND CORNER RECORDATION CERTIFICATE
Filing Requirement of Act 74, Mich. P.A. 1970

RECORDED ALPENA COUNTY MI.

For corners in Alpena County

(County)

Located In:

Corner Code #

- 1. Public Land Survey T 32N R 05E C-13
2. Property Controlling in Section S T R
3. Miscellaneous Property in Sec. S T R

OCT 12 2 13 PM '95

Kathryn Mptash REGISTER OF DEEDS

005761

Register of Deeds Stamp & File Number

- 4. Lot No. Recorded Plat
5. Private Claims

Grid table with columns A-M and rows 2-13, containing numbers 1-36.

Earl T. Lewis

May 10

1995

I, Earl T. Lewis, in a field survey on May 10, 1995, do hereby certify that under requirements of P.A. 74, Michigan P.A. of 1970, the corner points mentioned in lines 1 and 2 above were in conformance with regulations and rules therefore as required in the current manual of survey instructions of the United States Department of the Interior, Bureau of Land Management or by a decree of a Court of Law and/or that the corner points mentioned in lines 3, 4 and 5 above were in conformance with the rules of the Michigan Board of Land Surveyors or by a Decree of a Court of Law; established, re-established, monumented, re-monumented, recovered, found as expressed below:

NOTE: Not more than 4 corners, all in the same town and range, may be recorded on this certificate.

A. Description of original monument and accessories and/or subsequent restoration:

SEPTEMBER 19, 1855: GLO Surveyor, Butler Ives set post, no monumentation given, witnesses given:

Dead Tamarack 14 N 66° E 44, Dead Spruce 10 N 46° W 39

AUGUST 16, 1895: County Surveyor W. LeRoy, found cedar stake, witnesses given:

Cedar stake 5° N 46° E 70, Cedar stake 4° N 46° E 50

JUNE 27, 1913: County Surveyors, Jos. McNeil and W. LeRoy, found 1 1/2" gas pipe, no witnesses given.

MARCH 04, 1974: Porter Survey, found 6" long spike, witnesses given:

Due South Fe. Corner, N 35° W 138.30' 18" Maple, N 45° E 46.43' Fe. Cor

B. Description of corner evidence found and/or method applied in restoring or reestablishing corner:

Found 1/2" rerod in intersection of Long Rapids and Truax roads.

P.A. 345 ALPENA COUNTY PEER APPROVED 4/29/95


D. J. B. Lewis

C. Description of monument for corner and accessories established to perpetuate locating the position of the corner:

1995, Placed appropriately stamped Alpena County Remonumentation aluminum cap on set 1/2" x 36" rerod, which was set in place of 1/2" x 2.8' rerod, 6" below road surface.

Witnesses:

- S 10° W 57.35' 5" Maple
S 40° W 73.64' 5" Ash
S 70° W 181.05' Power Pole
S 70° E 145.65' 7" Maple

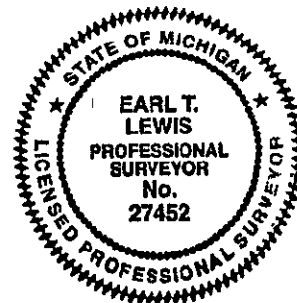

Signed by Earl T. Lewis

Date October 8, 1995

Surveyor's Michigan License No. 27452