

**SURVEY &
REMONUMENTATION**

NOV 16 1998

1998 Alpena County Remonumentation

SECTION

Liber **00002** Page **0162**

LAND CORNER RECORDATION CERTIFICATE
Filing Requirement of Act 74, Mich. P.A. 1970

For corners in

Alpena

(County)

Located In:

Corner Code #

1. Public Land Survey

T 32NR 06E

T 32NR 05E

T R

T R

A-2 ✓
M-2 ✓

2. Property Controlling
in Section

S T R

S T R

3. Miscellaneous
Property in Sec.

S T R

S T R

STATE OF MICHIGAN
County of Alpena
Recorded
10-08-1998 09:56:47
Kathy J. Matash
REGISTER OF DEEDS

Register of Deeds Stamp & File Number

4. Lot No. , Recorded Plat

5. Private Claims

I, Wayne T. Lewis, in a field survey on 5-19, 19 98 do hereby state that under requirements of P.A. 74, Michigan P.A. of 1970, the corner points mentioned in lines 1 and 2 above were in conformance with regulations and rules therefore as required in the current manual of survey instructions of the United States Department of the Interior, Bureau of Land Management or by a decree of a Court of Law and /or that the corner points mentioned in lines 3, 4 and 5 above were in conformance with the rules of the Michigan Board of Land Surveyors or by a Decree of a Court of Law; established, re-established, monumented, recovered, found as expressed below:

NOTE: Not more than 2 corners, all in the same town and range, may be recorded on this certificate.

1	A	B	C	D	E	F	G	H	I	J	K	L	M
2	6		5		4		3		2		1		
3													
4	7		8		9		10		11		12		
5													
6	18		17		16		15		14		13		
7													
8	19		20		21		22		23		24		
9													
10	30		29		28		27		26		25		
11													
12	31		32		33		34		35		36		
13													

A. Description of original monument and accessories and/or subsequent restoration:

- 1857: GLO, Josiah Knauer, D.S. - found old post & witnessed
- 1892: William Leroy, C.S. - re-established corner, set 4" square cedar stake & witnessed
- 1915: Joseph W. McNeil, C.S. - set new stake & witnessed
- 1981 & 1985: Earl T. Lewis, P.S. - found 1" pipe & witnessed
- 1994: Earl T. Lewis, P.S. - set 1/2" rebar w/cap #27452 & witnessed
- 1995: Ronald R. Bischer, P.S. - found 1/2" rod and cap #27452 (ETL) & witnessed

P.A. 345 ALPENA COUNTY
PEER APPROVED 8/10/98

Neil B. Gutten

B. Description of corner evidence found and/or method applied in restoring or reestablishing corner:

1998: Found 1/2" rerod 4' South of E/W road C/L, and in line with fence to the North


This corner position is accepted as a careful and faithful perpetuation of the position of the original corner.

C. Description of monument for corner and accessories established to perpetuate locating the position of the corner:

1998: Placed 3" Alpena County cap, stamped to identify the corner, on 1/2" rerod, 6" below road surface.

Witnesses:

- S 50° W 52.10' Power Pole (found nail)
- N 05° W 31.46' Center of Elm Stump (found nail)
- N 80° E 99.00' 5" Box Elder
- S 80° E 225.13' Power Pole (found nail)

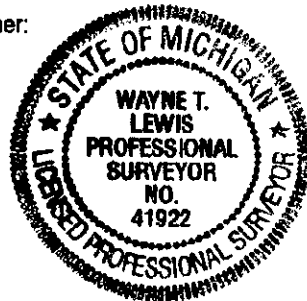

Signed by *Wayne T. Lewis*

Date September 19, 1998

Surveyor's Michigan License No. 41922