

SURVEY & REMONUMENTATION

NOV 16 1998

1998 Alpena County Remonumentation

SECTION

Liber 00002 Page 0163

LAND CORNER RECORDATION CERTIFICATE
Filing Requirement of Act 74, Mich. P.A. 1970

For corners in

Alpena

(County)

Located in:

Corner Code #

1. Public Land Survey

T 32NR 06E

A-3

T 32NR 05E

M-3

T R

T R

2. Property Controlling in Section

S T R

S T R

3. Miscellaneous Property in Sec.

S T R

S T R

STATE OF MICHIGAN

County of Alpena

Recorded

10-03-1998 09:56:55

Kathe J. Matash

REGISTER OF DEEDS

Register of Deeds Stamp & File Number

4. Lot No. , Recorded Plat

5. Private Claims

I, Wayne T. Lewis, in a field survey on 5-19, 1998 do hereby state that under requirements of P.A. 74, Michigan P.A. of 1970, the corner points mentioned in lines 1 and 2 above were in conformance with regulations and rules therefore as required in the current manual of survey instructions of the United States Department of the Interior, Bureau of Land Management or by a decree of a Court of Law and/or that the corner points mentioned in lines 3, 4 and 5 above were in conformance with the rules of the Michigan Board of Land Surveyors or by a Decree of a Court of Law; established, re-established, monumented, recovered, found as expressed below:

NOTE: Not more than 2 corners, all in the same town and range, may be recorded on this certificate.

Grid table with columns A-M and rows 1-13. Contains numbers 1-36 in a grid pattern.

A. Description of original monument and accessories and/or subsequent restoration:

- 1857: GLO, Josiah Knauer, D.S. - found old post & witnessed
1888: William Leroy, C.S. - found corner
1892: William Leroy, C.S. - re-established corner, set 4" square cedar stake & witnessed
1901: Joseph W. McNeil, C.S. - found corner
1915: Joseph W. McNeil, C.S. - set new stake in place of old one & witnessed
1973: Donald E. Marlatt, P.S. - recorded corner in Liber 1 of Corners, page 35 - found 1/2" steel rod & witnessed
1973: James L. Scott, P.S. - found 1/2" pin; recorded survey in Liber 1 of Surveys, page 205
1981, 1985 & 1986: Earl T. Lewis, P.S. - found 1/2" rod & witnessed
1994: Earl T. Lewis, P.S. - found 1/2" rebar & witnessed
1993 & 1995: Ronald R. Bischer, P.S. - found 1/2" rod & witnessed

3. Description of corner evidence found and/or method applied in restoring or reestablishing corner:

1998: Found 1/2" rered 4' North of road C/L to the East, 1' North of fence to the West, on C/L of road North & South, & witnessed

This corner position is accepted as a careful and faithful perpetuation of the position of the original corner.

P.A. 345 ALPENA COUNTY PEER APPROVED 8/10/98


Wayne T. Lewis signature

2. Description of monument for corner and accessories established to perpetuate locating the position of the corner:

1998: Placed 3" Alpena County cap, stamped to identify the corner, on 1/2" rered, 6" below road surface.

Witnesses:

- N 20° W 84.85' Triple Birch
N 25° W 57.70' 8" Birch (found nail & bottle cap)
West 30.36' Fence Corner
S 70° W 34.78' 6" Ash (found nail)
N 30° W 43.84' 6" Birch
N 50° W 32.48' 3" Spruce

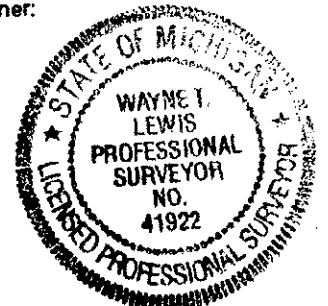

Signed by [Signature]
Surveyor's Michigan License No. 41922

Date September 19, 1998