

**SURVEY &
REMONUMENTATION**

NOV 16 1998

1998 Alpena County Remonumentation

SECTION

Liber **00002** Page **0164**

LAND CORNER RECORDATION CERTIFICATE
Filing Requirement of Act 74, Mich. P.A. 1970

For corners in
Alpena

(County)

Located In:

Corner Code #

1. Public Land Survey

T 32NR 06E

A-4 ✓

T 32NR 05E

M-4 ✓

T _____ R _____

T _____ R _____

2. Property Controlling
in Section

S _____ T _____ R _____

S _____ T _____ R _____

3. Miscellaneous
Property in Sec.

S _____ T _____ R _____

S _____ T _____ R _____

STATE OF MICHIGAN
County of Alpena
Recorded
10-08-1998 09:57:03
Kathy J. Matash
REGISTER OF DEEDS

Register of Deeds Stamp & File Number

4. Lot No. _____, Recorded Plat _____

5. Private Claims _____

I, Wayne T. Lewis, in a field survey on 5-19, 19 98 do hereby state that under requirements of P.A. 74, Michigan P.A. of 1970, the corner points mentioned in lines 1 and 2 above were in conformance with regulations and rules therefore as required in the current manual of survey instructions of the United States Department of the Interior, Bureau of Land Management or by a decree of a Court of Law and /or that the corner points mentioned in lines 3, 4 and 5 above were in conformance with the rules of the Michigan Board of Land Surveyors or by a Decree of a Court of Law; established, re-established, monumented, recovered, found as expressed below:

NOTE: Not more than 2 corners, all in the same town and range, may be recorded on this certificate.

	A	B	C	D	E	F	G	H	I	J	K	L	M
1													
2		6		5		4		3		2		1	
3													
4		7		8		9		10		11		12	
5													
6		18		17		16		15		14		13	
7													
8		19		20		21		22		23		24	
9													
10		30		29		28		27		26		25	
11													
12		31		32		33		34		35		36	
13													

A. Description of original monument and accessories and/or subsequent restoration:

- 1857: GLO, Josiah Knauer, D.S. - found old post & witnessed
- 1888: William H. Leroy, C.S. - found corner & witnessed
- 1901: Joseph W. McNeil, C.S. - found corner
- 1903: William H. Leroy, C.S. - found corner & renewed
- 1915: Joseph W. McNeil, C.S. - set new stake in place of old one
- 1973: Donald E. Marlatt, P.S. - recorded corner in Liber 1 of Corners, page 35 - found 1/2" steel rod & witnessed
- 1973: James L. Scott, P.S. - found 1/2" pin; recorded survey in Liber 1 of Surveys, page 205
- 1986: Earl T. Lewis, P.S. - found 1/2" rod & witnessed
- 1993: Ronald R. Bischer, P.S. - found 1/2" rod & witnessed
- 1992 & 1993: Earl T. Lewis, P.S. - found 1/2" rod & witnessed

B. Description of corner evidence found and/or method applied in restoring or reestablishing corner:

1998: Found 1/2" steel pin

This corner position is accepted as a careful and faithful perpetuation of the position of the original corner.

P.A. 345 ALPENA COUNTY

PEER APPROVED 8/10/98


Det. R. C. Cullen

C. Description of monument for corner and accessories established to perpetuate locating the position of the corner:

1998: Placed 3" Alpena County cap, stamped to identify the corner, on pin, 6" below road surface.

Witnesses:

- East 23.65' Most Northerly Maple in clump
- S 30° E 63.90' 6" Ash
- S 45° W 75.84' Power Pole (found nail)
- N 45° W 49.66' 12" Maple
- N 45° E 43.35' Power Pole

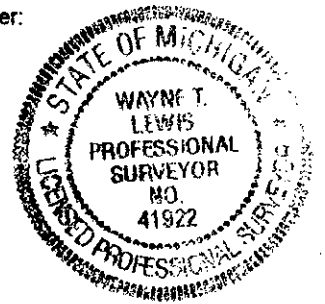

Signed by *Wayne T. Lewis*

Date September 19, 1998

Surveyor's Michigan License No. 41922