

**SURVEY &
REMONUMENTATION**

NOV 16 1998

1998 Alpena County Remonumentation

SECTION

Liber 00002 Page 0166

LAND CORNER RECORDATION CERTIFICATE
Filing Requirement of Act 74, Mich. P.A. 1970

For corners in

<u>Alpena</u> <small>(County)</small>	Located in:	Corner Code #
1. Public Land Survey	T 32NR 06E	A-6 ✓
	T 32NR 05E	M-6 ✓
	T R	
	T R	
2. Property Controlling in Section	S T R	
	S T R	
3. Miscellaneous Property in Sec.	S T R	
	S T R	

STATE OF MICHIGAN
County of Alpena
Recorded
10-08-1998 09:57:25
Kathe J. Matash
REGISTER OF DEEDS

Register of Deeds Stamp & File Number

4. Lot No. _____, Recorded Plat _____
5. Private Claims _____

I, Wayne T. Lewis, in a field survey on 5-19, 1998 do hereby state that under requirements of P.A. 74, Michigan P.A. of 1970, the corner points mentioned in lines 1 and 2 above were in conformance with regulations and rules therefore as required in the current manual of survey instructions of the United States Department of the Interior, Bureau of Land Management or by a decree of a Court of Law and/or that the corner points mentioned in lines 3, 4 and 5 above were in conformance with the rules of the Michigan Board of Land Surveyors or by a Decree of a Court of Law; established, re-established, monumented, recovered, found as expressed below:

NOTE: Not more than 2 corners, all in the same town and range, may be recorded on this certificate.

A	B	C	D	E	F	G	H	I	J	K	L	M
1												
2	6	5	4	3	2	1						
3												
4	7	8	9	10	11	12						
5												
6	18	17	16	15	14	13						
7												
8	19	20	21	22	23	24						
9												
10	30	29	28	27	26	25						
11												
12	31	32	33	34	35	36						
13												

A. Description of original monument and accessories and/or subsequent restoration:

- 1857: GLO, Josiah Knauer, D.S. - found old post & witnessed
- 1890: William H. Leroy, C.S. - found corner; set new stake in place of old one; buried plow point & iron pot; & witnessed
- 1902: William H. Leroy, C.S. - found stake
- 1915: Joseph W. McNeil, C.S. - set new stake in place of old one & deposited pieces of iron kettle around same
- 1976: David B. Guthrie, P.S. - found iron, raised with railroad spike & witnessed
- 1993: Earl T. Lewis, P.S. - found railroad spike and raised with 1/2" rod & witnessed

B. Description of corner evidence found and/or method applied in restoring or reestablishing corner:

1998: Used witness from E.T.L. survey; dug 3-foot-deep hole & got strong pull with metal detector; unable to find corner without digging larger hole; set 1/2" rod, 3' long, from E.T.L. 1993 witnesses.

E.T.L. 1993 Witnesses:

- S 30° E 52.00' Power Pole
- N 85° E 31.90' Road Sign
- S 30° W 60.23' Guy Pole
- S 45° W 67.95' 5" Maple

This corner position is accepted as a careful and faithful perpetuation of the position of the original corner.

P.A. 345 ALPENA COUNTY
PEER APPROVED 8/10/98


D.P. Conner

C. Description of monument for corner and accessories established to perpetuate locating the position of the corner:

1998: Placed 3" Alpena County cap, stamped to identify the corner, on existing rod, 6" below road surface.

Witnesses:

- S 30° E 52.00' Power Pole (found nail)
- S 30° W 60.23' Guy Pole
- S 45° W 67.75' 6" Maple
- S 40° W 64.27' 6" Cottonwood

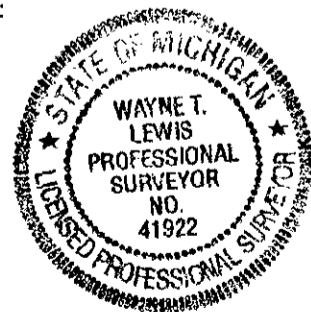

Signed by *Wayne T. Lewis*
Surveyor's Michigan License No. 41922

Date September 19, 1998