

SURVEY & REMONUMENTATION

NOV 16 1998

1998 Alpena County Remonumentation

SECTION

Liber 00002 Page 0168

LAND CORNER RECORDATION CERTIFICATE
Filing Requirement of Act 74, Mich. P.A. 1970

For corners in

Alpena

(County)

Located In:

Corner Code #

1. Public Land Survey

T 32NR 06E

A-8

T 32NR 05E

M-8

T R

T R

2. Property Controlling in Section

S T R

S T R

3. Miscellaneous Property in Sec.

S T R

S T R

STATE OF MICHIGAN
County of Alpena
Recorded
10-02-1998 09:57:44
Kathy J. Matash
REGISTER OF DEEDS

Register of Deeds Stamp & File Number

4. Lot No. _____, Recorded Plat _____
5. Private Claims _____

I, Wayne T. Lewis, in a field survey on 5-19, 19 98 do hereby state that under requirements of P.A. 74, Michigan P.A. of 1970, the corner points mentioned in lines 1 and 2 above were in conformance with regulations and rules therefore as required in the current manual of survey instructions of the United States Department of the Interior, Bureau of Land Management or by a decree of a Court of Law and/or that the corner points mentioned in lines 3, 4 and 5 above were in conformance with the rules of the Michigan Board of Land Surveyors or by a Decree of a Court of Law; established, re-established, monumented, recovered, found as expressed below:

NOTE: Not more than 2 corners, all in the same town and range, may be recorded on this certificate.

	A	B	C	D	E	F	G	H	I	J	K	L	M
1													
2		6		5		4		3		2		1	
3													
4		7		8		9		10		11		12	
5													
6		18		17		16		15		14		13	
7													
8		19		20		21		22		23		24	
9													
10		30		29		28		27		26		25	
11													
12		31		32		33		34		35		36	
13													

A. Description of original monument and accessories and/or subsequent restoration:

- 1857: GLO, Josiah Knauer, D.S. - set post & witnessed
- 1889: William H. Leroy, C.S. - set 3" cedar stake & witnessed
- 1915: Joseph W. McNeil, C.S. - found large stone
- 1976: David B. Guthrie, P.S. - set 1/2" iron rod & recorded survey in Liber 1 of Surveys, pages 326 & 327, & witnessed

B. Description of corner evidence found and/or method applied in restoring or reestablishing corner:

1998: Found 1/2" rerod 2' West of C/L of North/South road, 1' South of C/L of road to the West, and in line with fence to the East

This corner position is accepted as a careful and faithful perpetuation of the position of the original corner.


P.A. 345 ALPENA COUNTY
PEER APPROVED 8/10/98
D.B. Guthrie

C. Description of monument for corner and accessories established to perpetuate locating the position of the corner:

1998: Placed 3" Alpena County cap, stamped to identify the corner, on existing rod, 6" below road surface

Witnesses:

- N 15° W 125.53' Power Pole
- East 33.62' Fence Corner
- N 45° E 37.94' 10" Aspen
- S 80° E 36.23' Guy Pole
- S 80° W 35.27' Power Pole

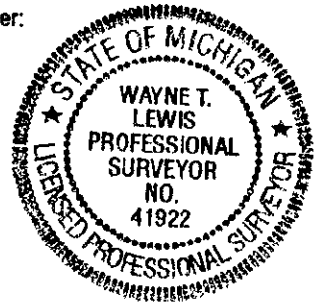

Signed by *Wayne T. Lewis*
Surveyor's Michigan License No. 41922

Date September 19, 1998