

**SURVEY &  
REMONUMENTATION**

NOV 16 1998

**P.A. 345 ALPENA COUNTY**  
PEER APPROVED 8/14/98  
*Daniel T. Kibbe*

SECTION  
**1998 Alpena County Remonumentation Corner**  
**LAND CORNER RECORDATION CERTIFICATE**  
Filing Requirement of Act 74, Mich. P.A. 1970

Liber **00002** Page **0139**

For corners in

<u>Alpena</u> (County)	Located In:	Corner Code #
1. Public Land Survey	T <u>32N</u> R <u>6E</u>	<u>A-13</u> ✓
	T <u>31N</u> R <u>5E</u>	<u>M-1</u> ✓
	T <u>32N</u> R <u>5E</u>	<u>M-13</u> ✓
	T <u>31N</u> R <u>6E</u>	<u>A-1</u> ✓
2. Property Controlling in Section	S _____ T _____ R _____	_____
	S _____ T _____ R _____	_____
3. Miscellaneous Property In Sec.	S _____ T _____ R _____	_____
	S _____ T _____ R _____	_____

STATE OF MICHIGAN  
County of Alpena  
Recorded  
08-20-1998 09:17:28  
Kathy J. Matash  
REGISTER OF DEEDS

Register of Deeds Stamp & File Number

4. Lot No. \_\_\_\_\_, Recorded Plat \_\_\_\_\_  
5. Private Claims \_\_\_\_\_

I, Daniel T. Kibbe, in a field survey on March 3, 1998 do hereby state that under requirements of P.A. 74, Michigan P.A. of 1970, the corner points mentioned in lines 1 and 2 above were in conformance with regulations and rules therefore as required in the current manual of survey instructions of the United States Department of the Interior, Bureau of Land Management or by a decree of a Court of Law and /or that the corner points mentioned in lines 3, 4 and 5 above were in conformance with the rules of the Michigan Board of Land Surveyors or by a Decree of a Court of Law; established, re-established, monumented, recovered, found as expressed below:

**NOTE:** Not more than 2 corners, all in the same town and range, may be recorded on this certificate.

1	A	B	C	D	E	F	G	H	I	J	K	L	M
2	6		5		4		3		2		1		
3													
4	7		8		9		10		11		12		
5													
6	18		17		16		15		14		13		
7													
8	19		20		21		22		23		24		
9													
10	30		29		28		27		26		25		
11													
12	31		32		33		34		35		36		

**A. Description of original monument and accessories and/or subsequent restoration:**

- 1855: GLO Survey by Buttler Ives-intersected North Boundry 4 links west of temporary post and set post corner of Townships 31 & 32 N Range 5 & 6E; referenced: Dead Cedar 14-S75E-34/Dead Cedar 10-S56W-32/Dead Cedar 15-N29W-20/Lynn 14-N12E-20
- 1889: County Survey by Wm. H. LeRoy-established 3" sq. cedar stake.
- 1995: Survey by David B. Guthrie-set 1/2" iron bar; referenced: 6" Ash-S70E-49.45'/P.Pole-N40E-47.33'/18" Spruce-S65W-66.81' P.Pole-S76W-68.0'

**B. Description of corner evidence found and/or method applied in restoring or reestablishing corner:**


- 1998: Remon. Survey by Daniel T. Kibbe-found 1/2" rebar 11' S of CL of road to West. 3' West of extended CL of road from South. 12' East of road CL.

This corner position is compatible with county & local surveys. This corner position is accepted as a careful and faithful perpetuation of the position of the original corner.

**C. Description of monument for corner and accessories established to perpetuate locating the position of the corner:**

- 1998: Placed 3" Alpena County cap stamped to identify the corner over 1/2" iron rod.  
Referenced:  
Found tag (DBG) in 6" ash-S67E-49.45'  
Found tag (DBG) in P.Pole-N45E-47.33'  
Found tag (DBG) in 18" Spruce-S65W-66.93'  
Found tag (DBG) in P.Pole-S76W-68.03'

Signed by *Daniel T. Kibbe*

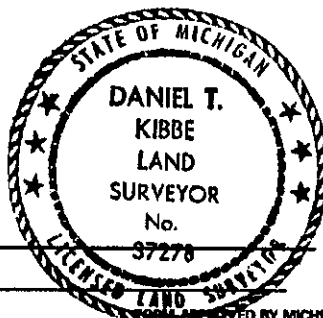

Date August 14, 1998

Surveyor's Michigan License No. 37278