1999 Alpena County Remonumentation

LAND CORNER RECORDATION CERTIFICATE
Filing Requirement of Act 74, Mich. P.A. 1970

For corners in

Alpena
(County)

Located in: Corner Code #

1. Public Land Survey — T 32N R 06E — G-4
   T___ R___
   T___ R___
   T___ R___
2. Property Controlling in Section — S___ T___ R___
   S___ T___ R___
3. Miscellaneous Property in Sec. — S___ T___ R___
   S___ T___ R___

RECEIVED
JAN 21 2000
SECTION

Register of Deeds Stamp & File Number

4. Lot No. _____, Recorded Plat _____
5. Private Claims _____

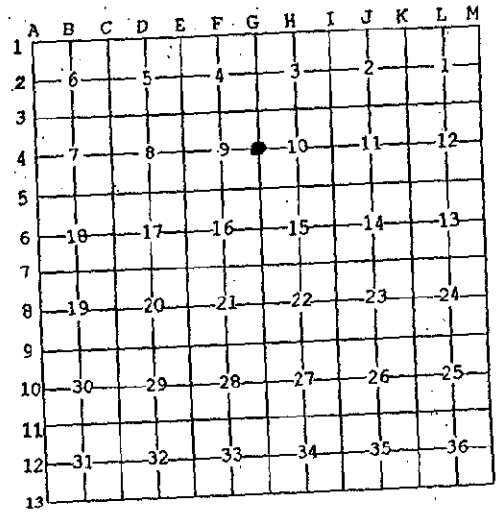

I, Wayne T. Lewis, in a field survey on 6-01, 19 99 do hereby state that under requirements of P.A. 74, Michigan P.A. of 1970, the corner points mentioned in lines 1 and 2 above were in conformance with regulations and rules therefore as required in the current manual of survey instructions of the United States Department of the Interior, Bureau of Land Management or by a decree of a Court of Law and /or that the corner points mentioned in lines 3, 4 and 5 above were in conformance with the rules of the Michigan Board of Land Surveyors or by a Decree of a Court of Law; established, re-established, monumented, recovered, found as expressed below:

NOTE: Not more than 2 corners, all in the same town and range, may be recorded on this certificate.

A. Description of original monument and accessories and/or subsequent restoration:

1856: Josiah Knauer reestablished old post and witnessed
1896: Wm. H. Leroy reestablished old corner, set new stake, 4" square, and witnessed
1962: G. Wozniak, MDOT Surveyor, found 1-1/4" pipe in mon. box 1.25' lt. of C/L of M-65
1978: E. D. Farrier, P.S., found 1" pipe in mon. box and recorded survey (L1, P734) and LCRC (L1, P102) and witnessed
1989: E. T. Lewis, P.S., found monument box, no witnesses given

B. Description of corner evidence found and/or method applied in restoring or reestablishing corner:

Found 1-1/4" pipe in mon. box, 1.5' West of M-65 C/L, and 4' North of Maple Lane Rd C/L

This corner position is accepted as a careful and faithful perpetuation of the position of the original corner.

P.A. 345 ALPENA COUNTY
PEER APPROVED 9/16/99

C. Description of monument for corner and accessories established to perpetuate locating the position of the corner:

1999: Placed 3" Alpena County Cap, stamped to identify the corner, on 1/2" rerod driven inside pipe

Witnesses:
N 20° E 173.45' 20" Maple
S 85° E 51.35' Fd. Rerod w/cap # 27452
N 71° W 130.95' Power Pole (Fd. MSHD Tag)
N 45° W 184.28' Easterly House Corner

STATE OF MICHIGAN
WAYNE T. LEWIS
PROFESSIONAL SURVEYOR
NO. 41922
LICENSED PROFESSIONAL SURVEYOR

Signed by _____ Date November 24, 1999

Surveyor's Michigan License No. 41922

L- 2 P- 246
11/30/1999 03:30P
Page: 1 of 1

FORM APPROVED BY MICHIGAN STATE BOARD OF PROFESSIONAL SURVEYORS, JAN. 28, 1971
REVISED MAY 14, 1975
REVISED JAN., 1983
REVISED OCT., 1995