

1999 Alpena County Remonumentation

LAND CORNER RECORDATION CERTIFICATE  
Filing Requirement of Act 74, Mich. P.A. 1970

For corners in

Alpena

(County)

Located In:

Corner Code #

1. Public Land Survey

T 32NR 06E

G-6

T      R     

T      R     

T      R     

2. Property Controlling  
in Section

S      T      R     

S      T      R     

3. Miscellaneous  
Property in Sec.

S      T      R     

S      T      R     

4. Lot No. \_\_\_\_\_, Recorded Plat \_\_\_\_\_  
5. Private Claims \_\_\_\_\_

REGISTERED

JAN 21 2000

SECTION

Register of Deeds Stamp & File Number

I, Wayne T. Lewis, in a field survey on 6-01, 19 99 do hereby state that under requirements of P.A. 74, Michigan P.A. of 1970, the corner points mentioned in lines 1 and 2 above were in conformance with regulations and rules therefore as required in the current manual of survey instructions of the United States Department of the Interior, Bureau of Land Management or by a decree of a Court of Law and/or that the corner points mentioned in lines 3, 4 and 5 above were in conformance with the rules of the Michigan Board of Land Surveyors or by a Decree of a Court of Law; established, re-established, monumented, recovered, found as expressed below:

NOTE: Not more than 2 corners, all in the same town and range, may be recorded on this certificate.

	A	B	C	D	E	F	G	H	I	J	K	L	M
1													
2	6		5		4		3		2		1		
3													
4	7		8		9		10		11		12		
5													
6	18		17		16		15		14		13		
7													
8	19		20		21		22		23		24		
9													
10	30		29		28		27		26		25		
11													
12	31		32		33		34		35		36		
13													

A. Description of original monument and accessories and/or subsequent restoration:

- 1856: Josiah Knauer reestablished old post and witnessed
- 1896: Wm. H. Leroy reestablished old corner, set granite stone, and witnessed
- 1900: J. McNeil, stone set in road in place of post, no witnesses given
- 1962: G. Wozniak, MDOT Surveyor, found 1-1/4" pipe in mon. box 9.81' ft. of M-65 C/L, and witnessed
- 1982: E. T. Lewis, P.S., found mon. box and witnessed
- 1997: W. T. Lewis, P.S., found pipe in mon. box, and witnessed

B. Description of corner evidence found and/or method applied in restoring or reestablishing corner:

Found 1-1/4" pipe in mon. box, 10.45' East of M-65 C/L

This corner position is accepted as a careful and faithful perpetuation of the position of the original corner.


C. Description of monument for corner and accessories established to perpetuate locating the position of the corner:

1999: Placed 3" Alpena County Cap, stamped to identify the corner, on 1/2" rerod driven inside pipe

Witnesses:

- N 85° W 67.02' Power Pole (Fd. Tag #41922 over MSHD Tag)
- West 49.64' ROW Marker
- S 45° W 104.34' 8" Red Pine (Fd. Tag #41922)
- East 69.95' ROW Marker

P.A. 345 ALPENA COUNTY  
PEER APPROVED 9/14/99  
*D.D.B. Cur*

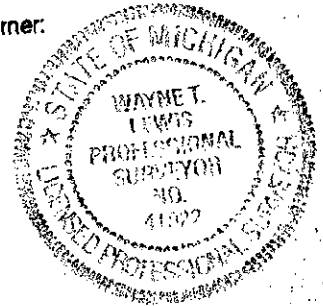

Signed by *Wayne T. Lewis*  
Surveyor's Michigan License No. 41922

Date November 24, 1999



L-2 P-248  
11/30/1999 03:30P  
Page: 1 of 1