1999 Alpena County Remonumentation

LAND CORNER RECORDATION CERTIFICATE
Filing Requirement of Act 74, Mich. P.A. 1970

For corners in
Alpena
(County)

Located In: Corner Code #

1. Public Land Survey — T 32N R 06E — G-8
   T___ R___
   T___ R___
   T___ R___
2. Property Controlling in Section — S___ T___ R___
   S___ T___ R___
3. Miscellaneous Property in Sec. — S___ T___ R___
   S___ T___ R___

RECEIVED
JAN 21 2000
SECTION

Register of Deeds Stamp & File Number

4. Lot No. _____, Recorded Plat _____
5. Private Claims _____

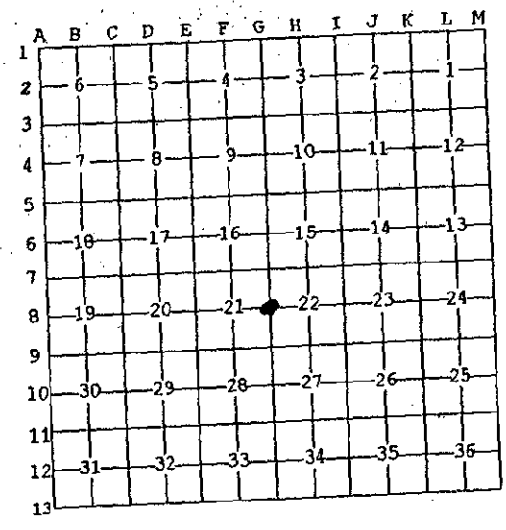

I, Wayne T. Lewis, in a field survey on 6-01, 19 99 do hereby state that under requirements of P.A. 74, Michigan P.A. of 1970, the corner points mentioned in lines 1 and 2 above were in conformance with regulations and rules therefore as required in the current manual of survey instructions of the United States Department of the Interior, Bureau of Land Management or by a decree of a Court of Law and /or that the corner points mentioned in lines 3, 4 and 5 above were in conformance with the rules of the Michigan Board of Land Surveyors or by a Decree of a Court of Law; established, re-established, monumented, recovered, found as expressed below:

NOTE: Not more than 2 corners, all in the same town and range, may be recorded on this certificate.

A. Description of original monument and accessories and/or subsequent restoration:

1856: Josiah Knauer reestablished old post and witnessed
1893: F. A. Rice found old stake, set Cedar stake 5" square with glass at bottom
1901: Wm. H. Leroy replaced old stake with reddish boulder, and witnessed
1962: G. Wozniak, MDOT Surveyor, found 1-1/4" pipe rt. of Highway, and witnessed
1976: R.S. Scott (D. B. Guthrie, P.S.) set R.R. spike, and witnessed

B. Description of corner evidence found and/or method applied in restoring or reestablishing corner:

Found 1-1/4" pipe 62.5' East of M-65 C/L

This corner position is accepted as a careful and faithful perpetuation of the position of the original corner.

P.A. 345 ALPENA COUNTY
PEER APPROVED 9/14/99
D.P.B. [illegible]

C. Description of monument for corner and accessories established to perpetuate locating the position of the corner:

1999: Placed 3" Alpena County Cap, stamped to identify the corner, on 1/2" rerod driven inside pipe

Witnesses:
East 53.15' 15" Cherry
S 70° E 59.02' NW Corner of Conc. Foundation
S 30° E 35.91' Service Power Pole
West 20.25' Set Chis. "X" in North end 15" Conc. Culv.

STATE OF MICHIGAN
WAYNE T. LEWIS
PROFESSIONAL SURVEYOR
NO. 41922
LICENSED PROFESSIONAL SURVEYOR

Signed by [signature] Date November 24, 1999
Surveyor's Michigan License No. 41922

L- 2 P- 250
11/30/1999 03:30P
Page: 1 of 1
Kathy J. Matash, Register Alpena Co., MI LDC 9.00

FORM APPROVED BY MICHIGAN STATE BOARD OF PROFESSIONAL SURVEYORS, JAN. 28, 1971
REVISED MAY 14, 1975
REVISED JAN., 1983
REVISED OCT., 1995