

1999 Alpena County Remonumentation

LAND CORNER RECORDATION CERTIFICATE
Filing Requirement of Act 74, Mich. P.A. 1970

For corners in
Alpena

(County)

Located In:

Corner Code #

1. Public Land Survey

T 32N R 06E

G-10

T R

T R

T R

T R

T R

T R

T R

2. Property Controlling
in Section

S

T R

S

T R

S

T R

S

T R

3. Miscellaneous
Property in Sec.

S

T R

S

T R

4. Lot No. _____, Recorded Plat _____

5. Private Claims _____

RECORDED

JAN 21 2000

SECTION

Register of Deeds Stamp & File Number

I, Wayne T. Lewis, in a field survey on 6-01, 1999 do hereby state that under requirements of P.A. 74, Michigan P.A. of 1970, the corner points mentioned in lines 1 and 2 above were in conformance with regulations and rules therefore as required in the current manual of survey instructions of the United States Department of the Interior, Bureau of Land Management or by a decree of a Court of Law and /or that the corner points mentioned in lines 3, 4 and 5 above were in conformance with the rules of the Michigan Board of Land Surveyors or by a Decree of a Court of Law; established, re-established, monumented, recovered, found as expressed below:

NOTE: Not more than 2 corners, all in the same town and range, may be recorded on this certificate.

	A	B	C	D	E	F	G	H	I	J	K	L	M
1													
2	6		5		4		3		2		1		
3													
4	7		8		9		10		11		12		
5													
6	18		17		16		15		14		13		
7													
8	19		20		21		22		23		24		
9													
10	30		29		28		27		26		25		
11													
12	31		32		33		34		35		36		
13													

A. Description of original monument and accessories and/or subsequent restoration:

- 1856: Josiah Knauer set post and witnessed
- 1893: Wm. H. Leroy set Cedar stake, 3" square, no witnesses given
- 1901: Wm. H. Leroy replaced old stake with blue boulder
- 1958: MDOT Surveyor found 1" iron pipe, and witnessed
- 1998: T. L. Fabis, P.S., set 50 penny nail over exist. iron, and witnessed
- 1999: W. T. Lewis found 3/8" pin 3' West of N/S C/L, and 2' South of East C/L, and witnessed

B. Description of corner evidence found and/or method applied in restoring or reestablishing corner:

Found 3/8" rerod over 1" pipe in intersection

This corner position is accepted as a careful and faithful perpetuation of the position of the original corner.


P.A. 345 ALPENA COUNTY
PEER APPROVED 9/16/99
D.D.B. Lewis

C. Description of monument for corner and accessories established to perpetuate locating the position of the corner:

1999: Placed 3" Alpena County Cap, stamped to identify the corner, on 1/2" rerod driven next to pipe

Witnesses:

- S 70° E 86.22' 6" Apple (Fd. Tag # 31591)
- S 30° E 88.00' Fe. Post (Fd. Tag #31591)
- S 55° W 54.52' Set Tag Over Fd. Large Shiner
- N 20° W 176.45' Power Pole (Fd. Tag #41922)

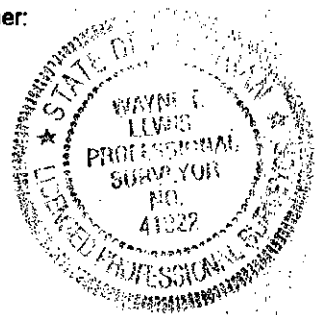

Signed by *Wayne T. Lewis*
Surveyor's Michigan License No. 41922

Date November 24, 1999