

JAN 25 2001

2000 ALPENA COUNTY REMONUMENTATION CORNER

LAND CORNER RECORDATION CERTIFICATE
Filing Requirement of Act 74, Mich. P.A. 1970

SECTION

For corners in

Alpena
(County)

Located In:

Corner Code #



L-2 P-300
08/02/2000 10:05
Page: 1 of 1
Kathy J. Matash, Register Alpena Co., MI LDC 2.00

1. Public Land Survey T32N R7E B-3
T___ R___ Maple Ridge Twp.
T___ R___
T___ R___
2. Property Controlling S___ T___ R___
in Section S___ T___ R___
3. Miscellaneous S___ T___ R___
Property in Sec. S___ T___ R___

Register of Deeds Stamp & File Number

4. Lot No. _____, Recorded Plat _____
5. Private Claims _____

I, Thomas L. Fabis, in a field survey on May 24, 2000 do hereby state that under requirements of P.A. 74, Michigan P.A. of 1970, the corner points mentioned in lines 1 and 2 above were in conformance with regulations and rules therefore as required in the current manual of survey instructions of the United States Department of the Interior, Bureau of Land Management or by a decree of a Court of Law and/or that the corner points mentioned in lines 3, 4 and 5 above were in conformance with the rules of the Michigan Board of Land Surveyors or by a Decree of a Court of Law; established, re-established, monumented, recovered, found as expressed below:

A	B	C	D	E	F	G	H	I	J	K	L	M
1												
2	6	5	4	3	2	1						
3	●											
4	7	8	9	10	11	12						
5												
6	18	17	16	15	14	13						
7												
8	19	20	21	22	23	24						
9												
10	30	29	28	27	26	25						
11												
12	31	32	33	34	35	36						
13												

NOTE: Not more than 2 corners, all in the same town and range, may be recorded on this certificate.

- A. Description of original monument and accessories and/or subsequent restoration:
 1855: G.L.O. Resurvey Josiah Knauer set post & referenced: Cedar 9 S54E 7 lks, Cedar 7 N20W 4 lks.
 1894: County Survey Fred A. Rice visits corner.
 1896: County Survey Wm. H. LeRoy Cedar stake 3" sq. and referenced.
 1992: Survey Duane R. MacNeill set 1" pipe.
 1995: Survey Liber 2 Page 908 & Liber 2 Page 937 & L.C.R.C. Liber 1 Page 366 Thomas L. Fabis found 1" pipe P.S.#19237 and referenced.


- B. Description of corner evidence found and/or method applied in restoring or reestablishing corner:
 2000: Found 1" pipe P.S.#19237, 2' North of road centerline, fences going North & South. Found one existing witness left: P. Pole S02W 38.23

The position of this corner is compatible with county and local surveys and is accepted as a careful and faithful perpetuation of the position of the original corner.

- C. Description of monument for corner and accessories established to perpetuate locating the position of the corner:
 2000: Removed 1" pipe P.S.#19237 and replaced it with 1/2" iron rod and 3" dia. alum. cap stamped to identify the corner. Witnesses are:
 P. Pole S02W 38.23
 Fe. Post S68E 88.17
 15" Apple S54E 128.74
 12" Apple South 126.98

P.A. 345 ALPENA COUNTY
PEER APPROVED 7-5-2000
D.J.B. Curran

Signed by Thomas L. Fabis
Surveyor's Michigan License No. 31591

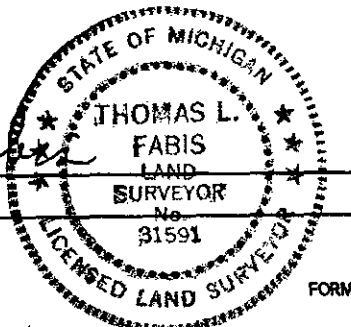

Date July 31, 2000