

JAN 25 2001

2000 ALPENA COUNTY REMONUMENTATION CORNER

LAND CORNER RECORDATION CERTIFICATE  
Filing Requirement of Act 74, Mich. P.A. 1970

SECTION

For corners in

Alpena  
(County)

Located In:

Corner Code #



L- 2 P- 298  
08/02/2000 10:05:  
Page: 1 of 1  
Kathy J. Matash, Register Alpena Co., MI LDC 8.00

- 1. Public Land Survey T 32NR 7E C-3  
T \_\_\_ R \_\_\_ Maple Ridge Twp.  
T \_\_\_ R \_\_\_  
T \_\_\_ R \_\_\_
- 2. Property Controlling in Section S \_\_\_ T \_\_\_ R \_\_\_  
S \_\_\_ T \_\_\_ R \_\_\_
- 3. Miscellaneous S \_\_\_ T \_\_\_ R \_\_\_  
Property in Sec. S \_\_\_ T \_\_\_ R \_\_\_

Register of Deeds Stamp & File Number

- 4. Lot No. \_\_\_\_\_, Recorded Plat \_\_\_\_\_
- 5. Private Claims \_\_\_\_\_

I, Thomas L. Fabis, in a field survey on May 24, 2000 do hereby state that under requirements of P.A. 74, Michigan P.A. of 1970, the corner points mentioned in lines 1 and 2 above were in conformance with regulations and rules therefore as required in the current manual of survey instructions of the United States Department of the Interior, Bureau of Land Management or by a decree of a Court of Law and/or that the corner points mentioned in lines 3, 4 and 5 above were in conformance with the rules of the Michigan Board of Land Surveyors or by a Decree of a Court of Law; established, re-established, monumented, recovered, found as expressed below:

NOTE: Not more than 2 corners, all in the same town and range, may be recorded on this certificate.

	A	B	C	D	E	F	G	H	I	J	K	L	M
1													
2	6		5			4			3			2	1
3			●										
4	7		8			9			10			11	12
5													
6	18		17			16			15			14	13
7													
8	19		20			21			22			23	24
9													
10	30		29			28			27			26	25
11													
12	31		32			33			34			35	36
13													

A. Description of original monument and accessories and/or subsequent restoration:

- 1855: G.L.O. Resurvey Josiah Knauer set post & referenced: Hemlock 12 S12½E 17 lks, Beech 10 N22½W 21 lks.
- 1896: County Survey Wm. H. LeRoy set gray limestone 25"x8"x7", marked "X" on top.
- 1897: County Survey Wm. H. LeRoy found limestone 25"x8"x7" and referenced.
- 1995: Field Notes W.O.95074 and L.C.R.C. Liber 1 Page 367 Thomas L. Fabis 1/2" iron rod and referenced.
- 1995: Survey Liber 2 Page 937 Thomas L. Fabis exis. 1/2" iron rod.
- 1999: Field Notes W.O.95074-1 Thomas L. Fabis 60 penny nail.

B. Description of corner evidence found and/or method applied in restoring or reestablishing corner:

- 2000: Found 60 penny nail over 1/2" iron rod and two existing witnesses: 16" Maple N35W 64.28, Old P. Pole N42E 48.74


The position fo this corner is compatible with county and local surveys and is accepted as a careful and faithful perpetuation of the position of the original corner.

C. Description of monument for corner and accessories established to perpetuate locating the position of the corner:

- 2000: Set 3" dia. alum. cap, stamped to identify the corner, over the existing 1/2" iron rod. Witnesses with tags #31591 are as follows:  
16" Maple N35W 64.28  
Old P. Pole N42E 48.74  
New P. Pole S44W 50.31  
12" Maple N55W 63.30

P.A. 345 ALPENA COUNTY  
PEER APPROVED 7-3-2000  
*J.D.B.*

Signed by Thomas L. Fabis

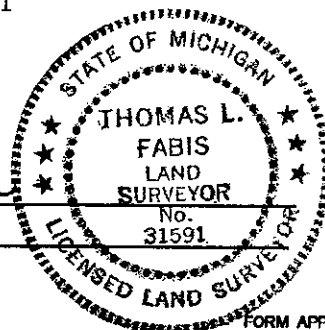

Date July 31, 2000

Surveyor's Michigan License No. 31591