

LAND CORNER RECORDATION CERTIFICATE
Filing Requirement of Act 74, Mich. P.A. 1970

SECTION

For corners in

Alpena
(County)

Located In:

Corner Code #



L- 2 P- 294
08/02/2000 10:05
Page: 1 of 1
Kathy J. Matash, Register Alpena Co., MI LDC 9.00

- 1. Public Land Survey T32N R7E D-3
T___ R___ Maple Ridge Twp.
T___ R___
T___ R___
- 2. Property Controlling in Section S___ T___ R___
S___ T___ R___
- 3. Miscellaneous Property in Sec. S___ T___ R___
S___ T___ R___

Register of Deeds Stamp & File Number

- 4. Lot No. _____, Recorded Plat _____
- 5. Private Claims _____

I, Thomas L. Fabis, in a field survey on May 24, 2000 do hereby state that under requirements of P.A. 74, Michigan P.A. of 1970, the corner points mentioned in lines 1 and 2 above were in conformance with regulations and rules therefore as required in the current manual of survey instructions of the United States Department of the Interior, Bureau of Land Management or by a decree of a Court of Law and /or that the corner points mentioned in lines 3, 4 and 5 above were in conformance with the rules of the Michigan Board of Land Surveyors or by a Decree of a Court of Law; established, re-established, monumented, recovered, found as expressed below:

1	A	B	C	D	E	F	G	H	I	J	K	L	M
2		6		5		4		3		2		1	
3				●									
4		7		8		9		10		11		12	
5													
6		18		17		16		15		14		13	
7													
8		19		20		21		22		23		24	
9													
10		30		29		28		27		26		25	
11													
12		31		32		33		34		35		36	
13													


NOTE: Not more than 2 corners, all in the same town and range, may be recorded on this certificate.

- A. Description of original monument and accessories and/or subsequent restoration:
- 1855: G.L.O. Resurvey Josiah Knauer Set post & referenced: Cedar 16 S23½W 31 lks, Cedar 10 N20E 16 lks.
 - 1906: County Survey Jos. McNeil found point of old stake and set new one.
 - 1910: County Survey Jos. W. McNeil stake previously set by him and referenced.
 - 1988: Survey W.O.4-595 Earl T. Lewis found R.R. Spike and referenced.
 - 1995: Field Notes W.O.95074 Thomas L. Fabis found R.R. Spike & set 1/2" iron rod.
 - 1999: Field Notes W.O.95074-1 Thomas L. Fabis found 1/2" iron rod & referenced.
 - 2000: Survey W.O.95074-1 Thomas L. Fabis found 1/2" iron rod & referenced.

- B. Description of corner evidence found and/or method applied in restoring or reestablishing corner:
- 2000: Found 1/2" iron rod with orange cap, 3' North of centerline gravel road.
Found 4 existing witnesses:
P. Pole N39W 35.85
R.R. X Sign N70E 65.58
12" Maple S24W 69.89
14" Spruce S54W 72.84

The position of this corner is compatible with county and local surveys and is accepted as a careful and faithful perpetuation of the position of the original corner.

- C. Description of monument for corner and accessories established to perpetuate locating the position of the corner:
- 2000: Removed existing plastic cap and set 3" dia. alum. cap, stamped to identify the corner, over the existing 1/2" iron rod. Existing witnesses with tags #31591:
P. Pole N39W 35.85
R.R. X Sign N70E 65.58
12" Maple S24W 69.89
14" Spruce S54W 72.84

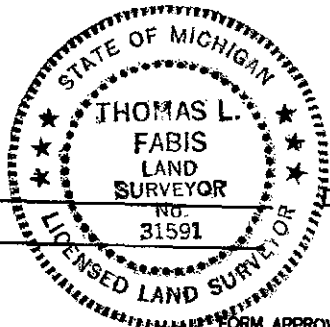

P.A. 345 ALPENA COUNTY
PEER APPROVED 7-5-2000
[Signature]

Signed by Thomas L. Fabis
Surveyor's Michigan License No. 31591

Date July 31, 2000