

LAND CORNER RECORDATION CERTIFICATE  
Filing Requirement of Act 74, Mich. P.A. 1970

JAN 25 2001

For corners in

Alpena  
(County)

Located In:

Corner Code #

SECTION

- 1. Public Land Survey T 32N R 7E
- T \_\_\_\_\_ R \_\_\_\_\_
- T \_\_\_\_\_ R \_\_\_\_\_
- T \_\_\_\_\_ R \_\_\_\_\_
- 2. Property Controlling S \_\_\_\_\_ T \_\_\_\_\_ R \_\_\_\_\_
- in Section S \_\_\_\_\_ T \_\_\_\_\_ R \_\_\_\_\_
- 3. Miscellaneous S \_\_\_\_\_ T \_\_\_\_\_ R \_\_\_\_\_
- Property in Section S \_\_\_\_\_ T \_\_\_\_\_ R \_\_\_\_\_

D-7  
Maple Ridge Twp.



L- 2 P- 301  
08/02/2000 10:08  
Page: 1 of 1  
Kathy J. Matash, Register Alpena Co., MI LDC 9.00

Register of Deeds Stamp & File Number

- 4. Lot No. \_\_\_\_\_, Recorded Plat \_\_\_\_\_
- 5. Private Claims \_\_\_\_\_

	A	B	C	D	E	F	G	H	I	J	K	L	M
2	6		5		4		3		2		1		
3													
4	7		8		9		10		11		12		
5													
6	18		17		16		15		14		13		
7													
8	19		20		21		22		23		24		
9													
10	30		29		28		27		26		25		
11													
12	31		32		33		34		35		36		
13													

I, Thomas L. Fabis, in a field survey on March 29, 2000, do hereby certify that under requirements of P.A. 74, Michigan P.A. of 1970, the corner points mentioned in lines 1 and 2 above were in conformance with regulations and rules therefore as required in the current manual of survey instructions of the United States Department of the Interior, Bureau of Land Management or by a decree of a Court of Law and/or that the corner points mentioned in lines 3, 4 and 5 above were in conformance with the rules of the Michigan Board of Professional Surveyors or by a Decree of a Court of Law; established, re-established, monumented, re-monumented, recovered, found as expressed below:

NOTE: Not more than 4 corners, all in the same town and range, may be recorded on this certificate.

A. Description of original monument and accessories and/or subsequent restoration:

- 1855: G.L.O. Resurvey Josiah Knauer set post & referenced: Cedar 20 S28W 7, do 17 N65W 9.
- 1918: County Survey Wm. H. LeRoy 1" buggy axle in road & referenced.
- 1980: Survey Liber 2 Page 49 Duane R. MacNeill set 1" pipe & referenced.
- 1980's: Co. Rd. Comm. Corner Records Gary St. Charles ex. 3/4" pipe.
- 1989: Survey W.O.4-692 Earl T. Lewis exis. 1" pipe & referenced.
- 1990: Survey W.O.4-993 Earl T. Lewis exis. 3/4" pipe & referenced.
- 1996: Survey W.O.4-2729-S Earl T. Lewis exis. 1" Pipe & referenced.

B. Description of corner evidence found and/or method applied in restoring or reestablishing corner:

- 2000: Found 1" pipe 3' South of gravel road centerline. Found the following witnesses by Lewis:
  - S80W 213.18 12" Maple
  - N80W 345.28 Power Pole
  - N80E 441.09 Power Pole

The position of this corner is compatible with county and local surveys and is accepted as a careful and faithful perpetuation of the position of the original corner.

C. Description of monument for corner and accessories established to perpetuate locating the position of the corner:


- 2000: Set 1/2" iron rod with 3" dia. alum. cap, stamped to identify the corner inside the existing 1" pipe. New witnesses are:
  - New P. Pole N50E 61.49
  - 3" Ash S75W 92.03
  - Culvert West End S75W 25.00
  - Culvert East End S10E 16.50

P.A. 345 ALPENA COUNTY  
PEER APPROVED 7-5-2000

*[Signature]*

Signed by

*Thomas L. Fabis*

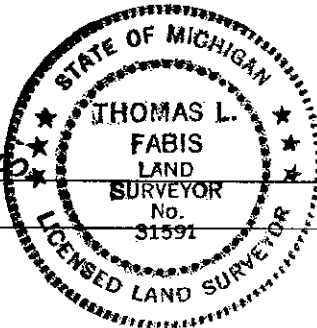

Date July 31, 2000

Surveyor's Michigan License No. 31591