

LAND CORNER RECORDATION CERTIFICATE
Filing Requirement of Act 74, Mich. P.A. 1970

JAN 25 2001

For corners in Alpena (County)

Located In:

Corner Code #

SECTION

- 1. Public Land Survey T 32N R 7E
2. Property Controlling in Section S T R
3. Miscellaneous Property in Section S T R

E-3
Maple Ridge Twp.



L- 2 P- 303
08/02/2000 10:05
Page: 1 of 1
Kathy J. Matash, Register Alpena Co., MI LDC 9.00

Register of Deeds Stamp & File Number

- 4. Lot No. , Recorded Plat
5. Private Claims

I, Thomas L. Fabis, in a field survey on May 24, 2000, do hereby certify that under requirements of P.A. 74, Michigan P.A. of 1970, the corner points mentioned in lines 1 and 2 above were in conformance with regulations and rules therefore as required in the current manual of survey instructions of the United States Department of the Interior, Bureau of Land Management or by a decree of a Court of Law and/or that the corner points mentioned in lines 3, 4 and 5 above were in conformance with the rules of the Michigan Board of Professional Surveyors or by a Decree of a Court of Law; established, re-established, monumented, re-monumented, recovered, found as expressed below:

NOTE: Not more than 4 corners, all in the same town and range, may be recorded on this certificate.

Grid table with columns A-M and rows 2-13. A black dot is located at the intersection of column E and row 3.

A. Description of original monument and accessories and/or subsequent restoration:

- 1855: G.L.O. Resurvey Josiah Knauer set post & referenced: Hem 30 N44W 44, do 40 S61E 54.
1906: County Survey Jos. McNeil 2" iron gas pipe set in roadbed w/stakes drove beside it.
1981: R.S.Scott Survey W.O.4-6164 David Guthrie exis. 1/2" iron rod & referenced.
1982: Survey Liber 2 Page 254 Duane R. MacNeill found 3/4" rerod & referenced.
1988: R.S.Scott Survey W.O.4-7457 David Guthrie exis. 1/2" iron rod & referenced.
1988: Survey W.O.4-595 Earl Lewis 1/2" rod & referenced.
1990: Survey W.O.1015 Earl Lewis exis. 1/2" rod & referenced.
1998: Survey W.O.205-98 Ronald Bischer note: different location 1 1/2" pipe & referenced.
1999: Survey Field Notes W.O.95074-1 Fabis exis. 1/2" iron rod & referenced.
1999: Co. Rd. Comm. Corner Records Gary St. Charles found ex. 1/2" rerod & referenced.

B. Description of corner evidence found and/or method applied in restoring or reestablishing corner:

2000: Found 1/2" iron rod 4' North of road centerline and, also, found 1 1/2" gas pipe 9.5' North of road centerline and 4 Bischer tagged witnesses matching his survey with the 1 1/2" gas pipe. Survey Crew Report: We dug up the 1 1/2" gas pipe to check for wood stake remnants beside it, as per County Survey Notes by Jos. McNeil. No wood was found. In the process, it was discovered that the pipe was loose in the gravel and near the surface and the pipe was only 8" long. It is our opinion that this pipe may not be in the same location as reported by Jos. McNeil. All the other surveyors are using the 1/2" iron rod which is our recommendation for the corner to be remonumented.

C. Description of monument for corner and accessories established to perpetuate locating the position of the corner:


- 2000: Set 3" dia. alum. cap, stamped to identify the corner, over the existing 1/2" iron rod. Witnesses with tag #22428:
5" Spruce N52W 36.22
P. Pole N8W 28.77
16" Beech S52E 75.73
6" Aspen S48E 51.08
1 1/2" pipe N30W 6.06

P.A. 345 ALPENA COUNTY
PEER APPROVED 7-5-2000

D.J.B. [Signature]

Signed by

Thomas L. Fabis [Signature]

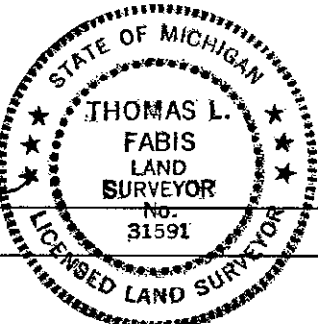

Date July 31, 2000

Surveyor's Michigan License No. 31591