

LAND CORNER RECORDATION CERTIFICATE
Filing Requirement of Act 74, Mich. P.A. 1970

JAN 25 2001

For corners in Alpena (County)

Located In:

Corner Code #

SECTION

- 1. Public Land Survey T 32N R 7E
2. Property Controlling in Section S T R
3. Miscellaneous Property in Section S T R

E-7
Maple Ridge Twp



L-2 P-302
08/02/2000 10:05
Page: 1 of 1

Kathy J. Matash, Register Alpena Co., MI LDC 9.00

Register of Deeds Stamp & File Number

- 4. Lot No. , Recorded Plat
5. Private Claims

Grid table with columns A-M and rows 1-13. A black dot is located at row 7, column E.

I, Thomas L. Fabis, in a field survey on April 13, 2000, do hereby certify that under requirements of P.A. 74, Michigan P.A. of 1970, the corner points mentioned in lines 1 and 2 above were in conformance with regulations and rules therefore as required in the current manual of survey instructions of the United States Department of the Interior, Bureau of Land Management or by a decree of a Court of Law and/or that the corner points mentioned in lines 3, 4 and 5 above were in conformance with the rules of the Michigan Board of Professional Surveyors or by a Decree of a Court of Law; established, re-established, monumented, re-monumented, recovered, found as expressed below:

NOTE: Not more than 4 corners, all in the same town and range, may be recorded on this certificate.

A. Description of original monument and accessories and/or subsequent restoration:

- 1855: G.L.O. Resurvey Josiah Knauer set post & referenced: Hem 23 N29 1/2 E 17, Hem 16 S61W 10.
1970's: Alpena Co. Rd. Comm. Records Gary St. Charles found ex. RR Spike & rered & referenced.
1980: Survey Liber 2 Page 40 Duane R. MacNeill set 1" pipe 17.55 East of exis. RR Spike & referenced.
1980: R.S.Scott Survey W.O.4-6082 David Guthrie exis. RR Spike & referenced.
1989: Survey W.O.4-692 Earl T. Lewis Exis. 1/2" rod & referenced.
1990: Survey W.O.4-1106 Earl T. Lewis exis. 1/2" rod & referenced.
1998: Survey Liber 3 Page 128 & Survey W.O.0403506S Wayne Lewis exis. 1/2" rered & RR Spike & referenced.
1999: Survey Liber 3 Page 192 Thomas Fabis exis. 1/2" iron rod & RR Spike.

B. Description of corner evidence found and/or method applied in restoring or reestablishing corner:

- 2000: Found 1/2" iron rod & RR Spike at centerline of paved road (LaComb Rd.), new fence going North, old fence going South. Found D.R.M. pipe 17.53 feet East with old downed cattle fence going South from it. Found Lewis tags in the following 3 existing witnesses to the 1/2" iron rod:
P. P. N43E 61.06
3" Balsam N47E 53.92
Fe. Post South 45.76

The position of the 1/2" iron rod & R.R. Spike is compatible with county and local surveys and harmonizes best with the occupational fence lines in this area. It is accepted as a careful and faithful perpetuation of the position of the original corner.

C. Description of monument for corner and accessories established to perpetuate locating the position of the corner:


- 2000: Removed R.R. Spike and set 3" dia. alum. cap, stamped to identify the corner, over the existing 1/2" iron rod. Monument box to be installed over this corner by Alpena County Road Commission. Witnesses are:
Lewis tag in P.P. N43 61.06
Lewis tag in 3" Balsam N47E 53.92
Lewis tag in Fe. Post South 45.76
Tag #31591 in Fe. Post S37W 61.08
D.R.M. pipe East 17.53

P.A. 345 ALPENA COUNTY
PEER APPROVED 7-5-2000
D.B. [Signature]

Signed by

Thomas L. Fabis

Surveyor's Michigan License No. 31591

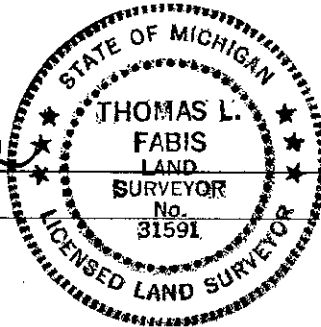

Date July 31, 2000