

JAN 25 2001

2000 ALPENA COUNTY REMONUMENTATION CORNER

LAND CORNER RECORDATION CERTIFICATE
Filing Requirement of Act 74, Mich. P.A. 1970

SECTION

For corners in

Alpena
(County)

Located in:

Corner Code #



L- 2 P- 290
08/02/2000 10:00
Page: 1 of 1
Kathy J. Matash, Register Alpena Co., MI LDC 9.00

- | | | |
|------------------------------------|--|------------------|
| 1. Public Land Survey | T <u>32</u> N R <u>7E</u> | F-7 |
| | T <u> </u> R <u> </u> | Maple Ridge Twp. |
| | T <u> </u> R <u> </u> | _____ |
| | T <u> </u> R <u> </u> | _____ |
| 2. Property Controlling in Section | S <u> </u> T <u> </u> R <u> </u> | _____ |
| | S <u> </u> T <u> </u> R <u> </u> | _____ |
| 3. Miscellaneous Property in Sec. | S <u> </u> T <u> </u> R <u> </u> | _____ |
| | S <u> </u> T <u> </u> R <u> </u> | _____ |

Register of Deeds Stamp & File Number

4. Lot No. _____, Recorded Plat _____
5. Private Claims _____

I, Thomas L. Fabis, in a field survey on April 13, 2000 do hereby state that under requirements of P.A. 74, Michigan P.A. of 1970, the corner points mentioned in lines 1 and 2 above were in conformance with regulations and rules therefore as required in the current manual of survey instructions of the United States Department of the Interior, Bureau of Land Management or by a decree of a Court of Law and/or that the corner points mentioned in lines 3, 4 and 5 above were in conformance with the rules of the Michigan Board of Land Surveyors or by a Decree of a Court of Law; established, re-established, monumented, recovered, found as expressed below:

NOTE: Not more than 2 corners, all in the same town and range, may be recorded on this certificate.

	A	B	C	D	E	F	G	H	I	J	K	L	M
1													
2	6		5		4		3		2		1		
3													
4	7		8		9		10		11		12		
5													
6	18		17		16		15		14		13		
7													
8	19		20		21		22		23		24		
9													
10	30		29		28		27		26		25		
11													
12	31		32		33		34		35		36		
13													

A. Description of original monument and accessories and/or subsequent restoration:

- 1855: G.L.O. Resurvey Josiah Knauer set post & referenced: Hem 27 S18½E 8, Sugar 30 N48W 30.
- 1913: County Survey Jos. McNeil old stake in road bed, set new cedar stake.
- 1996: Survey W.O.4-2783-S Earl T. Lewis exist. P.K. nail, set 1/2" rerod w/cap & referenced.
- 1997: R.S.Scott Survey W.O.4-9766 David B. Guthrie exist. 1/2" Iron rod & referenced.
- 1998: Surveys Liber 3 Page 128 & W.O.0403506S Wayne T. Lewis found 1/2" rerod w/cap & referenced.
- 1999: Survey Liber 3 Page 192 Thomas L. Fabis found 1/2" iron rod w/cap.

B. Description of corner evidence found and/or method applied in restoring or reestablishing corner:

- 2000: Existing 1/2" iron rod capped P.S.#27452 3.5 feet North of centerline asphalt road (LaComb Rd.), rock pile fence going South. Found the following witnesses indicating that this is the same corner used by Lewis and Guthrie:
 - Fe. Post N30E 38.60
 - P. Pole S60E 94.10
 - 7" Pine S50W 91.84
 - 10" Apple S80W 44.79


The position of this corner is compatible with county and local surveys and is accepted as a careful and faithful perpetuation of the position of the original corner.

C. Description of monument for corner and accessories established to perpetuate locating the position of the corner:

- 2000: Removed existing plastic cap and set 3" dia. alum. cap, stamped to identify the corner over the existing 1/2" iron rod. Monument box to be installed over this corner by Alpena County Road Commission. Witnesses are:
 - Fe. Post N30E 38.60
 - P. Pole S60E 94.10
 - 7" Pine S50W 91.84
 - 10" Apple S80W 44.79

P.A. 345 ALPENA COUNTY
PEER APPROVED 7-5-2000
D.J.B. Gurn

Signed by Thomas L. Fabis
Surveyor's Michigan License No. 31591

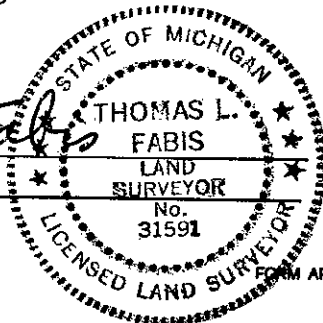

Date July 31, 2000