

JAN 25 2001

LAND CORNER RECORDATION CERTIFICATE
Filing Requirement of Act 74, Mich. P.A. 1970

SECTION

For corners in

Alpena
(County)

Located In:

Corner Code #

L- 2 P- 291
08/02/2000 10:05
Page: 1 of 1
Kathy J. Matash, Register Alpena Co., MI LDC 9.00

- 1. Public Land Survey T32N R7E G-3
T___ R___ Maple Ridge Twp.
T___ R___
T___ R___
- 2. Property Controlling S___ T___ R___
in Section S___ T___ R___
- 3. Miscellaneous S___ T___ R___
Property in Sec. S___ T___ R___

Register of Deeds Stamp & File Number

- 4. Lot No. _____, Recorded Plat _____
- 5. Private Claims _____

I, Thomas L. Fabis, in a field survey on May 5, 2000 do hereby state that under requirements of P.A. 74, Michigan P.A. of 1970, the corner points mentioned in lines 1 and 2 above were in conformance with regulations and rules therefore as required in the current manual of survey instructions of the United States Department of the Interior, Bureau of Land Management or by a decree of a Court of Law and /or that the corner points mentioned in lines 3, 4 and 5 above were in conformance with the rules of the Michigan Board of Land Surveyors or by a Decree of a Court of Law; established, re-established, monumented, recovered, found as expressed below:

NOTE: Not more than 2 corners, all in the same town and range, may be recorded on this certificate.

	A	B	C	D	E	F	G	H	I	J	K	L	M
1													
2	6		5		4		3		2		1		
3							●						
4	7		8		9		10		11		12		
5													
6	18		17		16		15		14		13		
7													
8	19		20		21		22		23		24		
9													
10	30		29		28		27		26		25		
11													
12	31		32		33		34		35		36		
13													

A. Description of original monument and accessories and/or subsequent restoration:

- 1855: G.L.O. Resurvey Josiah Knauer set post & referenced: Hemlock 22 N34½W 14 links, Hemlock 36 S12E 20 links.
- 1893: County Survey Fred A. Rice visits corner, witness tree standing.
- 1894: County Survey Wm. H. LeRoy found remains of both ONBT's to cedar stake 3" sq.
- 1982: L.C.R.C. Liber 1 Page 153 & Porter's Witness Records Ronald Bischer found 2" pipe and referenced.
- 1990: Survey W.O.4-1010 Earl T. Lewis existing 1½" pipe and referenced.
- 1994: Hendrick's Mortgage Report Thomas L. Fabis 2" Pipe.

B. Description of corner evidence found and/or method applied in restoring or reestablishing corner:

- 2000: Found 2" Pipe at intersection of gravel road centerlines. Found one existing witness: Shiner in P. Pole S45W 43.24 indicating that this is the same corner used by Bischer and Lewis.

The position of this corner is compatible with county and local surveys and is accepted as a careful and faithful perpetuation of the position of the original corner.

C. Description of monument for corner and accessories established to perpetuate locating the position of the corner:


- 2000: Set 1/2" iron rod with 3" dia. alum. cap stamped to identify the corner inside the existing 2" Pipe.

Witnesses are:

- Shiner in P. Pole S45W 43.24
- Fe. Cor. Post S54E 39.91
- 23" Maple N52E 76.08
- Fe. Post N22W 30.08

P.A. 345 ALPENA COUNTY
PEER APPROVED 7-5-2000
D.J.B.

Signed by Thomas L. Fabis
Surveyor's Michigan License No. 31591

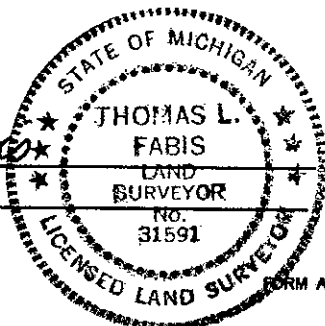

Date July 31, 2000