

SURVEY & REMONUMENTATION

JAN 25 2001

2000 ALPENA COUNTY REMONUMENTATION CORNER

LAND CORNER RECORDATION CERTIFICATE
Filing Requirement of Act 74, Mich. P.A. 1970

SECTION

For corners in

Alpena
(County)

Located in:

Corner Code #



L- 2 P- 295
08/02/2000 10:05
Page: 1 of 1
Kathy J. Matash, Register Alpena Co., MI LDC 9.00

1. Public Land Survey T 32N R 7E G-5
T R Maple Ridge Twp.
T R
T R
2. Property Controlling S T R
in Section S T R
3. Miscellaneous S T R
Property in Sec. S T R

Register of Deeds Stamp & File Number

4. Lot No. _____, Recorded Plat _____
5. Private Claims _____

I, Thomas L. Fabis, in a field survey on May 24 2000 do hereby state that under requirements of P.A. 74, Michigan P.A. of 1970, the corner points mentioned in lines 1 and 2 above were in conformance with regulations and rules therefore as required in the current manual of survey instructions of the United States Department of the Interior, Bureau of Land Management or by a decree of a Court of Law and /or that the corner points mentioned in lines 3, 4 and 5 above were in conformance with the rules of the Michigan Board of Land Surveyors or by a Decree of a Court of Law; established, re-established, monumented, recovered, found as expressed below:

NOTE: Not more than 2 corners, all in the same town and range, may be recorded on this certificate.

	A	B	C	D	E	F	G	H	I	J	K	L	M
1													
2	6		5		4		3		2		1		
3													
4	7		8		9		10		11		12		
5							●						
6	18		17		16		15		14		13		
7													
8	19		20		21		22		23		24		
9													
10	30		29		28		27		26		25		
11													
12	31		32		33		34		35		36		
13													

A. Description of original monument and accessories and/or subsequent restoration:

- 1855: G.L.O. Resurvey Josiah Knauer set post & referenced: Sugar 20 N29E 49 lks, Beech 13 S32W 32 lks.
- 1897: County Survey Fred A. Rice visits corner.
- 1913: County Survey Jos. McNeil found corner in crossroads.
- 1985: Survey W.O.4-221 Earl T. Lewis found 1/2" Rod & referenced: S45W 54.4 Power Pole, N45W 43.0 Tel. Pole.
- 1995: Remon. Survey Lewis & Lewis measures 1 mile to the South.

B. Description of corner evidence found and/or method applied in restoring or reestablishing corner:

- 2000: Found 1/2" iron rod at intersection of centerlines of N-S gravel road (Dietz Rd.) and E-W gravel road (Daggett Rd.). Found one witness: P. Pole S38W 54.12


The position of this corner is compatible with county and local surveys and is accepted as a careful and faithful perpetuation of the position of the original corner.

C. Description of monument for corner and accessories established to perpetuate locating the position of the corner:

- 2000: Set 3" dia. alum. cap stamped to identify the corner, over the existing 1/2" iron rod. Existing witness: P. Pole S38W 54.12
Set new witnesses:
Cor. Fe. Post N28E 53.61
Fe. Post N24E 64.11
3" Scotch Pine S44W 67.51

P.A. 345 ALPENA COUNTY
PEER APPROVED 7-5-2000
D.D.B.L.

Signed by Thomas L. Fabis
Surveyor's Michigan License No. 31591

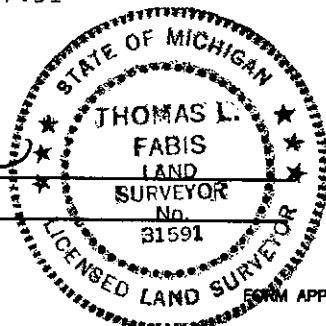

Date July 31, 2000