

LAND CORNER RECORDATION CERTIFICATE
Filing Requirement of Act 74, Mich. P.A. 1970

RECORDED
ALPENA COUNTY MI.

JUL 31 9 58 AM '95

Daniel T. Kibbe
REGISTER OF DEEDS

For corners in

<u>Alpena</u> <small>(County)</small>	Located In:	Corner Code #
1. Public Land Survey	T <u>32</u> N R <u>7</u> E	<u>G-10</u>
	T _____ R _____	_____
	T _____ R _____	_____
	T _____ R _____	_____
2. Property Controlling in Section	S _____ T _____ R _____	_____
	S _____ T _____ R _____	_____
3. Miscellaneous Property in Sec.	S _____ T _____ R _____	_____
	S _____ T _____ R _____	_____
4. Lot No. _____, Recorded Plat _____		
5. Private Claims _____		

Register of Deeds Stamp & File Number

I, Daniel T. Kibbe, in a field survey on April 20, 19 95, do hereby certify that under requirements of P.A. 74, Michigan P.A. of 1970, the corner points mentioned in lines 1 and 2 above were in conformance with regulations and rules therefore as required in the current manual of survey instructions of the United States Department of the Interior, Bureau of Land Management or by a decree of a Court of Law and/or that the corner points mentioned in lines 3, 4 and 5 above were in conformance with the rules of the Michigan Board of Land Surveyors or by a Decree of a Court of Law; established, re-established, monumented, re-monumented, recovered, found as expressed below:

NOTE: Not more than 4 corners, all in the same town and range, may be recorded on this certificate.

A	B	C	D	E	F	G	H	I	J	K	L	M
2	6	5	4	3	2	1						
3												
4	7	8	9	10	11	12						
5												
6	16	17	18	15	14	13						
7												
8	19	20	21	22	23	24						
9												
10	30	29	28	27	26	25						
11												
12	31	32	33	34	35	36						
13												

A. Description of original monument and accessories and/or subsequent restoration:

- 1857: G.L.O. Resurvey by Josiah Knauer - set quarter section post & referenced: W. Birch 5 - S 45 W - 24 / S. Birch 7 - S 37 E - 6.
- 1897: County Survey by Fred A. Rice - one witness Birch standing.
- 1994: Survey by Tom Fabis - set 1/2" iron rod over existing 1" iron pipe.

B. Description of corner evidence found and/or method applied in restoring or reestablishing corner:

- 1995: Found 1/2" iron rod 0.2' below bit surface, 2' West of C/L Deitz Road. Under iron rod, found 1" pipe.

This corner position is compatible with county and local surveys. This corner position is accepted as a careful and faithful perpetuation of the position of the original corner.

SURVEY &
REMONUMENTATION

AUG 23 1995

COMMISSION


P.A. 345 ALPENA COUNTY
PEER APPROVED 6/6/95
Daniel B. Cook

C. Description of monument for corner and accessories established to perpetuate locating the position of the corner:

- 1995: Placed 3" aluminum cap stamped to identify the corner on existing 1/2" iron rod over existing 1" iron pipe in monument box.

Referenced:

- N 84° W - 30.96' - Set N/Tag in fence post
- S 20° E - 131.20' - Set N/Tag in Power Pole
- N 20° E - 109.28' - Set N/Tag in mailbox post
- N 24° E - 211.04' - Set N/Tag in Power Pole
- N 84° E - 9.89' - Earl Lewis PK nail used as 1/4 corner in 1993 survey.

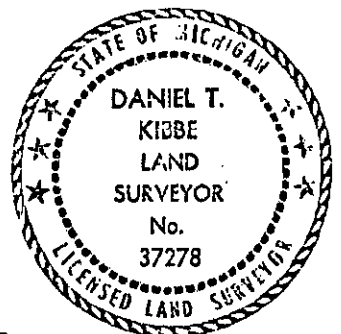

Signed by *Daniel T. Kibbe*

Date July 24, 1995

Surveyor's Michigan License No. 37278