

1995 Alpena County Remonumentation Corner LIBER

JUL 31 9 59 AM '95

Myriam H. Johnston
REGISTER OF DEEDS

LAND CORNER RECORDATION CERTIFICATE
Filing Requirement of Act 74, Mich. P.A. 1970

For corners in

Alpena

(County)

Located In:

Corner Code #

| | | | | | |
|------------------------------------|---|-----|---|----|------|
| 1. Public Land Survey | T | 32N | R | 7E | G-12 |
| | T | | R | | |
| | T | | R | | |
| | T | | R | | |
| 2. Property Controlling in Section | S | | T | R | |
| | S | | T | R | |
| 3. Miscellaneous Property in Sec. | S | | T | R | |
| | S | | T | R | |

Register of Deeds Stamp & File Number

4. Lot No. _____, Recorded Plat _____
5. Private Claims _____

| A | B | C | D | E | F | G | H | I | J | K | L | M |
|----|----|----|----|----|----|----|---|---|---|---|---|---|
| 2 | 6 | 5 | 4 | 3 | 2 | 1 | | | | | | |
| 3 | | | | | | | | | | | | |
| 4 | 7 | 8 | 9 | 10 | 11 | 12 | | | | | | |
| 5 | | | | | | | | | | | | |
| 6 | 18 | 17 | 16 | 15 | 14 | 13 | | | | | | |
| 7 | | | | | | | | | | | | |
| 8 | 19 | 20 | 21 | 22 | 23 | 24 | | | | | | |
| 9 | | | | | | | | | | | | |
| 10 | 30 | 29 | 28 | 27 | 26 | 25 | | | | | | |
| 11 | | | | | | | | | | | | |
| 12 | 31 | 32 | 33 | 34 | 35 | 36 | | | | | | |
| 13 | | | | | | | | | | | | |

I, Daniel T. Kibbe, in a field survey on April 20, 19 95, do hereby certify that under requirements of P.A. 74, Michigan P.A. of 1970, the corner points mentioned in lines 1 and 2 above were in conformance with regulations and rules therefore as required in the current manual of survey instructions of the United States Department of the Interior, Bureau of Land Management or by a decree of a Court of Law and/or that the corner points mentioned in lines 3, 4 and 5 above were in conformance with the rules of the Michigan Board of Land Surveyors or by a Decree of a Court of Law; established, re-established, monumented, re-monumented, recovered, found as expressed below:

NOTE: Not more than 4 corners, all in the same town and range, may be recorded on this certificate.

A. Description of original monument and accessories and/or subsequent restoration:

- 1857: G.L.O. Resurvey by Josiah Knauer - Old line found, no post. Set quarter section post & referenced: Aspen 6 - N 43 W - 9 / W. Birch 7 - S 83 E - 2 1/2.
- 1890: County Survey by Wm. H. LeRoy - found O.N.B.T.'s, set cedar stake 4" sq.
- 1959: Dietz Park Subdivision - not identified, used as P.O.B.
- 1981: Survey by Duane MacNeill - found 1/2" rerod.
- 1986,89: Survey by Earl Lewis - existing 5/8" rod & referenced.
- 1993: Survey by Tom Fabis - existing 5/8" iron rod & referenced.

B. Description of corner evidence found and/or method applied in restoring or reestablishing corner:

1995: Found 5/8" x 10 3/4" iron rod flush with road, 5' West of C/L Deitz Road.

This corner position is compatible with county and local surveys. This corner position is accepted as a careful and faithful perpetuation of the position of the original corner.

SURVEY &
REMONUMENTATION

AUG 23 1995

COMMISSION


P.A. 345 ALPENA COUNTY
PEER APPROVED 6/6/95
Det. B. Law

C. Description of monument for corner and accessories established to perpetuate locating the position of the corner:

1995: Set 1/2" x 18" iron rod with 3" aluminum cap stamped to identify the corner in monument box.

Referenced:

- N 37° W - 98.67' - N/Tag in Power Pole
- S 53° E - 48.92' - N/Tag in 6" W. Pine
- S 75° E - 57.50' - N/Tag in 8" W. Pine
- S 35° W - 67.04' - Set N/Tag in 4" Maple

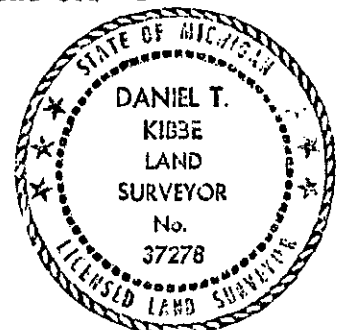

Signed by Daniel T. Kibbe

Date July 24, 1995

Surveyor's Michigan License No. 37278